

INSTALLATION OF NEW
ROOF MOUNTED PV SOLAR SYSTEM
29 WELDON LN
PORT JEFFERSON STATION, NY 11776



VICINITY MAP
SCALE: NTS



SATELLITE VIEW
SCALE: NTS

GENERAL NOTES

1. THE INSTALLATION CONTRACTOR IS RESPONSIBLE FOR INSTALLING ALL EQUIPMENT AND FOLLOWING ALL DIRECTIONS AND INSTRUCTIONS CONTAINED IN THE DRAWING PACKAGE AND INFORMATION RECEIVED FROM TRINITY.
2. THE INSTALLATION CONTRACTOR IS RESPONSIBLE FOR INSTALLING ALL EQUIPMENT AND FOLLOWING ALL DIRECTIONS AND INSTRUCTION CONTAINED IN THE COMPLETE MANUAL.
3. THE INSTALLATION CONTRACTOR IS RESPONSIBLE FOR READING AND UNDERSTANDING ALL DRAWINGS, COMPONENT AND INVERTER MANUALS PRIOR TO INSTALLATION. THE INSTALLATION CONTRACTOR IS ALSO REQUIRED TO HAVE ALL COMPONENT SWITCHES IN THE OFF POSITION AND FUSES REMOVED PRIOR TO THE INSTALLATION OF ALL FUSE BEARING SYSTEM COMPONENTS.
4. ONCE THE PHOTOVOLTAIC MODULES ARE MOUNTED, THE INSTALLATION CONTRACTOR SHOULD HAVE A MINIMUM OF ONE ELECTRICIAN WHO HAS ATTENDED A SOLAR PHOTOVOLTAIC INSTALLATION COURSE ON SITE.
5. FOR SAFETY, IT IS RECOMMENDED THAT THE INSTALLATION CREW ALWAYS HAVE A MINIMUM OF TWO PERSONS WORKING TOGETHER AND THAT EACH OF THE INSTALLATION CREW MEMBERS BE TRAINED IN FIRST AID AND CPR.
6. THIS SOLAR PHOTOVOLTAIC SYSTEM IS TO BE INSTALLED FOLLOWING THE CONVENTIONS OF THE NATIONAL ELECTRICAL CODE. ANY LOCAL CODE WHICH MAY SUPERSEDE THE NEC SHALL GOVERN.
7. ALL SYSTEM COMPONENTS TO BE INSTALLED WITH THIS SYSTEM ARE TO BE "UL" LISTED. ALL EQUIPMENT WILL BE NEMA 3R OUTDOOR RATED UNLESS INDOORS.

GENERAL NOTES

IF ISSUED DRAWING IS MARKED WITH A REVISION CHARACTER OTHER THAN "A", PLEASE BE ADVISED THAT FINAL EQUIPMENT AND/OR SYSTEM CHARACTERISTICS ARE SUBJECT TO CHANGE DUE TO AVAILABILITY OF EQUIPMENT.

GENERAL NOTES CONTINUED

8. THE DC VOLTAGE FROM THE PANELS IS ALWAYS PRESENT AT THE DC DISCONNECT ENCLOSURE AND THE DC TERMINALS OF THE INVERTER DURING DAYLIGHT HOURS. ALL PERSONS WORKING ON OR INVOLVED WITH THE PHOTOVOLTAIC SYSTEM ARE WARNED THAT THE SOLAR MODULES ARE ENERGIZED WHENEVER THEY ARE EXPOSED TO LIGHT.
9. ALL PORTIONS OF THIS SOLAR PHOTOVOLTAIC SYSTEM SHALL BE MARKED CLEARLY IN ACCORDANCE WITH THE NATIONAL ELECTRICAL CODE ARTICLE 690 & 705.
10. PRIOR TO THE INSTALLATION OF THIS PHOTOVOLTAIC SYSTEM, THE INSTALLATION CONTRACTOR SHALL ATTEND A PRE-INSTALLTION MEETING FOR THE REVIEW OF THE INSTALLATION PROCEDURES, SCHEDULES, SAFETY AND COORDINATION.
11. PRIOR TO THE SYSTEM START UP THE INSTALLATION CONTRACTOR SHALL ASSIST IN PERFORMING ALL INITIAL HARDWARE CHECKS AND DC WIRING CONDUCTIVITY CHECKS.
12. FOR THE PROPER MAINTENANCE AND ISOLATION OF THE INVERTERS REFER TO THE ISOLATION PROCEDURES IN THE OPERATION MANUAL.
13. THE LOCATION OF PROPOSED ELECTRIC AND TELEPHONE UTILITIES ARE SUBJECT TO FINAL APPROVAL OF THE APPROPRIATE UTILITY COMPANIES AND OWNERS.
14. ALL MATERIALS, WORKMANSHIP AND CONSTRUCTION FOR THE SITE IMPROVEMENTS SHOWN HEREIN SHALL BE IN ACCORDANCE WITH:
 - A) CURRENT PREVAILING MUNICIPAL AND/OR COUNTY SPECIFICATIONS, STANDARDS AND REQUIREMENTS

GENERAL NOTES CONTINUED

14. B) CURRENT PREVAILING UTILITY COMPANY SPECIFICATIONS, STANDARDS, AND REQUIREMENTS
15. THIS SET OF PLANS HAVE BEEN PREPARED FOR THE PURPOSE OF MUNICIPAL AND AGENCY REVIEW AND APPROVAL. THIS SET OF PLANS SHALL NOT BE UTILIZED AS CONSTRUCTION DRAWINGS UNTIL REVISED TO INDICATE "ISSUED FOR CONSTRUCTION".
16. ALL INFORMATION SHOWN MUST BE CERTIFIED PRIOR TO USE FOR CONSTRUCTION ACTIVITIES.

2018 NOTES

- PV INSTALLATION TO COMPLY WITH THE FOLLOWING PUBLICATIONS:
- 140 M.P.H. WIND REQUIREMENT ([HTTP://WINDSPEED.ATCOUNCIL.ORG](http://WINDSPEED.ATCOUNCIL.ORG))
 - 2015 INTERNATIONAL RESIDENTIAL CODE
 - 2016 NYS SUPPLEMENT (R 324)
 - 2014 NATIONAL ELECTRICAL CODE
 - ASCE7-10

ABBREVIATIONS

- | | |
|-----|--|
| AMP | AMPERE |
| AC | ALTERNATING CURRENT |
| AL | ALUMINUM |
| AF | AMP. FRAME |
| AFF | ABOVE FINISHED FLOOR |
| AFG | ABOVE FINISHED GRADE |
| AWG | AMERICAN WIRE GAUGE |
| C | CONDUIT (GENERIC TERM OF RACEWAY, PROVIDE AS SPECIFIED) |
| CB | COMBINER BOX |
| CKT | CIRCUIT |
| CT | CURRENT TRANSFORMER |
| CU | COPPER |
| DC | DIRECT CURRENT |

ABBREVIATIONS CONTINUED


- | | |
|--------|--|
| DISC | DISCONNECT SWITCH |
| DWG | DRAWING |
| EC | ELECTRICAL SYSTEM INSTALLER |
| EMT | ELECTRICAL METALLIC TUBING |
| FS | FUSIBLE SWITCH |
| FU | FUSE |
| GND | GROUND |
| GFI | GROUND FAULT INTERRUPTER |
| HZ | FREQUENCY (CYCLES PER SECOND) |
| JB | JUNCTION BOX |
| KCMIL | THOUSAND CIRCULAR MILS |
| KVA | KILO-VOLT AMPERE |
| KW | KILO-WATT |
| KWH | KILO-WATT HOUR |
| L | LINE |
| MCB | MAIN CIRCUIT BREAKER |
| MDP | MAIN DISTRIBUTION PANEL |
| MLO | MAIN LUG ONLY |
| MTD | MOUNTED |
| MTG | MOUNTING |
| N | NEUTRAL |
| NEC | NATIONAL ELECTRICAL CODE |
| NIC | NOT IN CONTRACT |
| NO # | NUMBER |
| NTS | NOT TO SCALE |
| OCP | OVER CURRENT PROTECTION |
| P | POLE |
| PB | PULL BOX |
| PH Ø | PHASE |
| PVC | POLY-VINYL CHLORIDE CONDUIT |
| PWR | POWER |
| QTY | QUANTITY |
| RGS | RIGID GALVANIZED STEEL |
| SN | SOLID NEUTRAL |
| JSWBD | SWITCHBOARD |
| TYP | TYPICAL |
| U.O.I. | UNLESS OTHERWISE INDICATED |
| WP | WEATHERPROOF |
| XFMR | TRANSFORMER |
| +72 | MOUNT 72 INCHES TO BOTTOM OF ABOVE FINISHED FLOOR OR GRADE |

SHEET INDEX

- | | |
|------|----------------------------------|
| PV-1 | COVER SHEET W/ SITE INFO & NOTES |
| PV-2 | ROOF PLAN W/ MODULE LOCATIONS |
| PV-3 | RACKING DETAILS |
| PV-4 | ELECTRICAL 3 LINE DIAGRAM |
| AP | APPENDIX |

Engineer / License Holder:

Nicolas A. Nitti, P.E.
N.Y. P.E. LIC. # 091373
100 Great Oaks Boulevard
Albany, NY 12203
(518) 313-7153
nnitti@westshorede.com

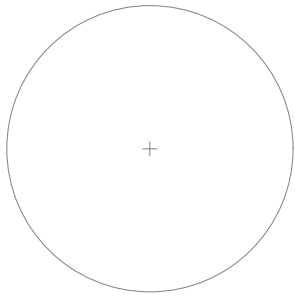

Issued / Revisions

A1	AS BUILT	9/5/2018
P1	ISSUED TO TOWNSHIP FOR PERMIT	6/18/2018
NO.	DESCRIPTION	DATE

Project Title:

REID, TRAVIS

TRINITY ACCT #: 2018-05-260764

Project Address:

29 WELDON LN
PORT JEFFERSON STATION, NY 11776
40.929083,-73.056771
SCTM: 0200-160.00-04.00-006.000

Drawing Title:

AS BUILT PV SOLAR SYSTEM

Drawing Information

DRAWING DATE:	6/18/2018
DRAWN BY:	IG
REVISED BY:	JMS

System Information:

DC SYSTEM SIZE:	7.67kW
AC SYSTEM SIZE:	6kW
TOTAL MODULE COUNT:	26
MODULES USED:	HANWHA 295
MODULE SPEC #:	Q.PEAK-BLK G4.1 295
UTILITY COMPANY:	PSEG-LI
UTILITY ACCT #:	8561019504
UTILITY METER #:	42437072
DEAL TYPE:	SUNNOVA

Rev. No.

A1


Sheet

PV - 1




2211 Allenwood Road
Wall, New Jersey 07719

877-786-7283
www.Trinity-Solar.com

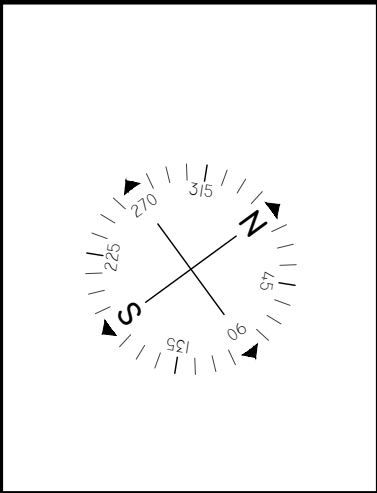

ARRAY SCHEDULE

ROOF 1 MODULES: 8 PITCH: 23° ORIENTATION: 36°
ROOF 2 MODULES: 10 PITCH: 23° ORIENTATION: 216°
ROOF 3 MODULES: 0 PITCH: 23° ORIENTATION: 126°
ROOF 4 MODULES: 8 PITCH: 23° ORIENTATION: 306°
ROOF 5 MODULES: 0 PITCH: 23° ORIENTATION: 126°
ROOF 6 MODULES: 0 PITCH: 23° ORIENTATION: 306°

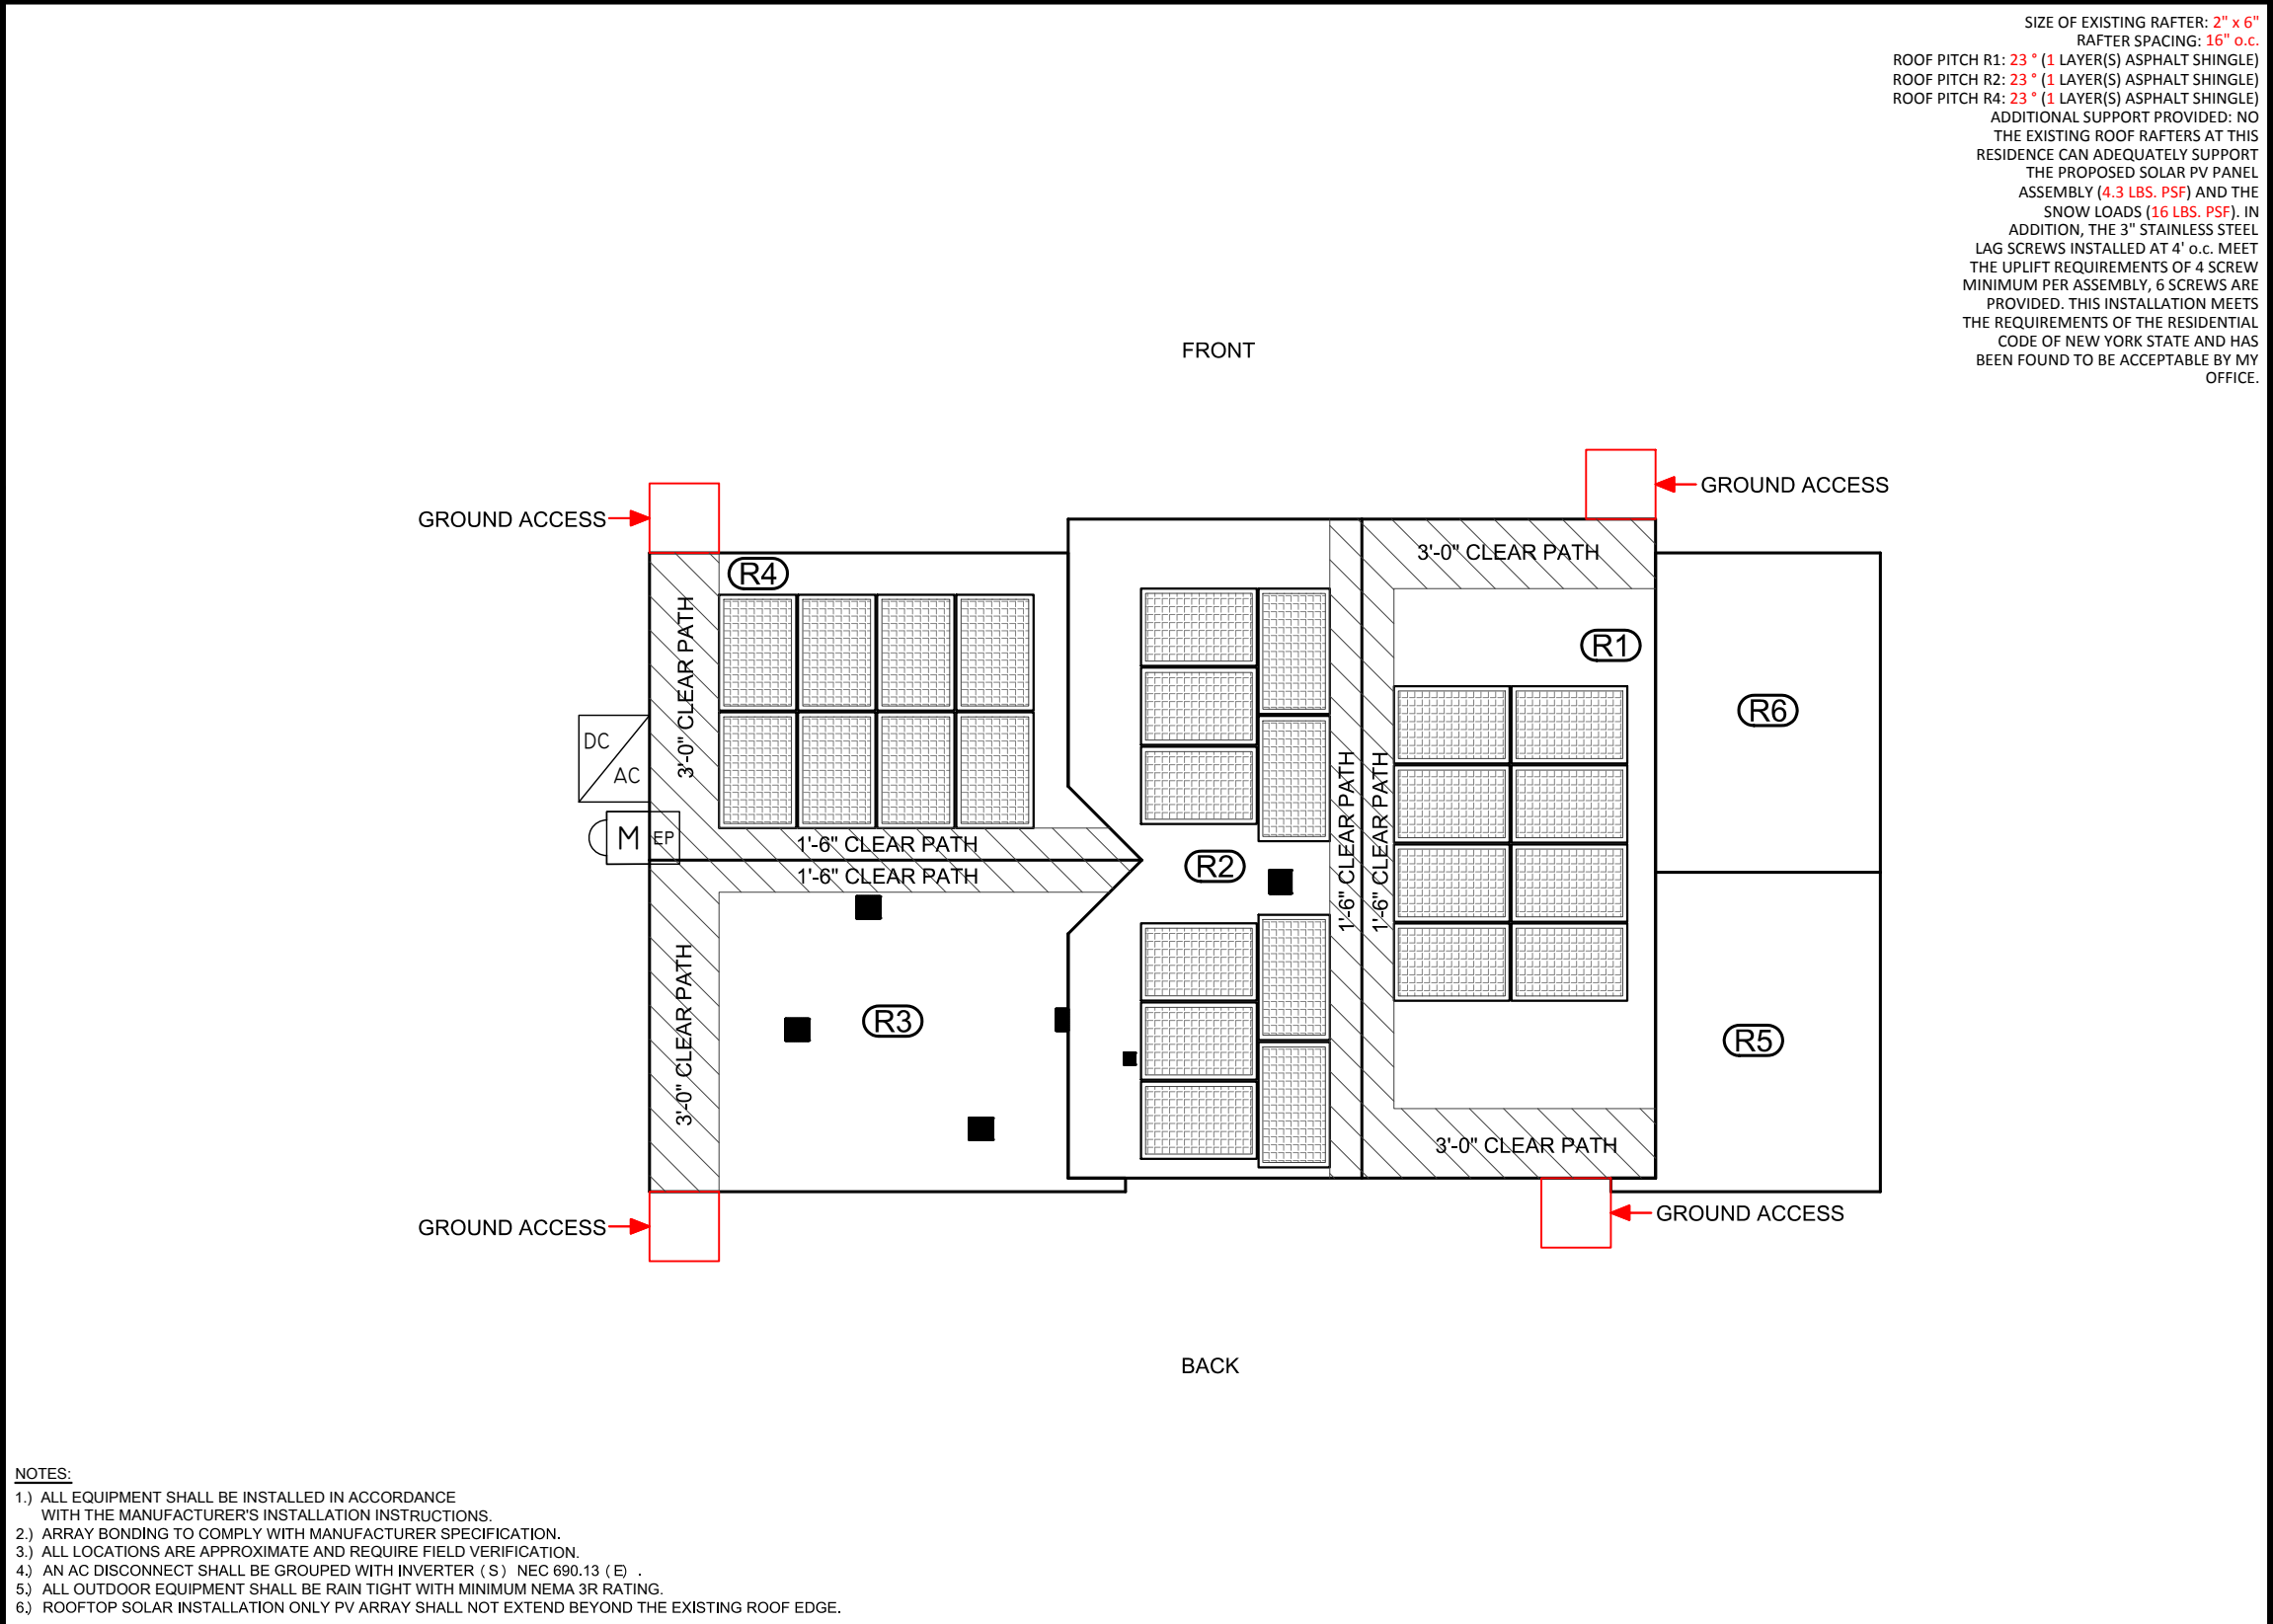

SIZE OF EXISTING RAFTER: 2" x 6"
RAFTER SPACING: 16" o.c.
ROOF PITCH R1: 23 ° (1 LAYER(S) ASPHALT SHINGLE)
ROOF PITCH R2: 23 ° (1 LAYER(S) ASPHALT SHINGLE)
ROOF PITCH R4: 23 ° (1 LAYER(S) ASPHALT SHINGLE)
ADDITIONAL SUPPORT PROVIDED: NO
THE EXISTING ROOF RAFTERS AT THIS RESIDENCE CAN ADEQUATELY SUPPORT THE PROPOSED SOLAR PV PANEL ASSEMBLY (4.3 LBS. PSF) AND THE SNOW LOADS (16 LBS. PSF). IN ADDITION, THE 3" STAINLESS STEEL LAG SCREWS INSTALLED AT 4' o.c. MEET THE UPLIFT REQUIREMENTS OF 4 SCREW MINIMUM PER ASSEMBLY, 6 SCREWS ARE PROVIDED. THIS INSTALLATION MEETS THE REQUIREMENTS OF THE RESIDENTIAL CODE OF NEW YORK STATE AND HAS BEEN FOUND TO BE ACCEPTABLE BY MY OFFICE.

Engineer / License Holder:

Nicolas A. Nitti, P.E.
N.Y. P.E. LIC. # 091373
100 Great Oaks Boulevard
Albany, NY 12203
(518) 313-7153
nnitti@westshorede.com

Issued / Revisions

NO.	DESCRIPTION	DATE
A1	AS BUILT	9/5/2018
P1	ISSUED TO TOWNSHIP FOR PERMIT	6/18/2018

Project Title:

REID, TRAVIS
TRINITY ACCT #: 2018-05-260764

Project Address:

29 WELDON LN
PORT JEFFERSON STATION, NY 11776
40.929083,-73.056771
SCTM: 0200-160.00-04.00-006.000

Drawing Title:

AS BUILT PV SOLAR SYSTEM

Drawing Information

DRAWING DATE:	6/18/2018
DRAWN BY:	IG
REVISED BY:	JMS

System Information:


DC SYSTEM SIZE:	7.67kW
AC SYSTEM SIZE:	6kW
TOTAL MODULE COUNT:	26
MODULES USED:	HANWHA 295
MODULE SPEC #:	Q.PEAK-BLK G4.1 295
UTILITY COMPANY:	PSEG-LI
UTILITY ACCT #:	8561019504
UTILITY METER #:	42437072
DEAL TYPE:	SUNNOVA

Rev. No.	Sheet
A1	PV - 2

2211 Allenwood Road
Wall, New Jersey 07719

877-786-7283
www.Trinity-Solar.com

SYMBOL LEGEND					PLUMBING SCHEDULE	EQUIPMENT SCHEDULE	
(R1)	INDICATES ROOF DESIGNATION . REFER TO ARRAY SCHEDULE FOR MORE INFORMATION	UD	INDICATES NEW UTILITY DISCONNECT TO BE INSTALLED OUTSIDE	SP	INDICATES NEW PV ONLY SUBPANEL TO BE INSTALLED	QTY	SPEC #
M	INDICATES EXISTING METER LOCATION		INDICATES NEW PV SOLAR MODULE. RED MODULES INDICATE PANELS THAT USE MICRO INVERTERS. REFER TO EQUIPMENT SCHEDULE FOR SPECS.			26	HANWHA 295 (Q.PEAK-BLK G4.1 295)
EP	INDICATES EXISTING ELECTRICAL PANEL LOCATION: INSIDE	P	INDICATES NEW PRODUCTION METER TO BE INSTALLED OUTSIDE.			1	SE6000H-US000NNC2
D	INDICATES NEW FUSED PV DISCONNECT TO BE INSTALLED INSIDE	DC/AC	INDICATES NEW INVERTER TO BE INSTALLED OUTSIDE. REFER TO EQUIPMENT SCHEDULE FOR SPECS.				
					OTHER OBSTRUCTIONS		

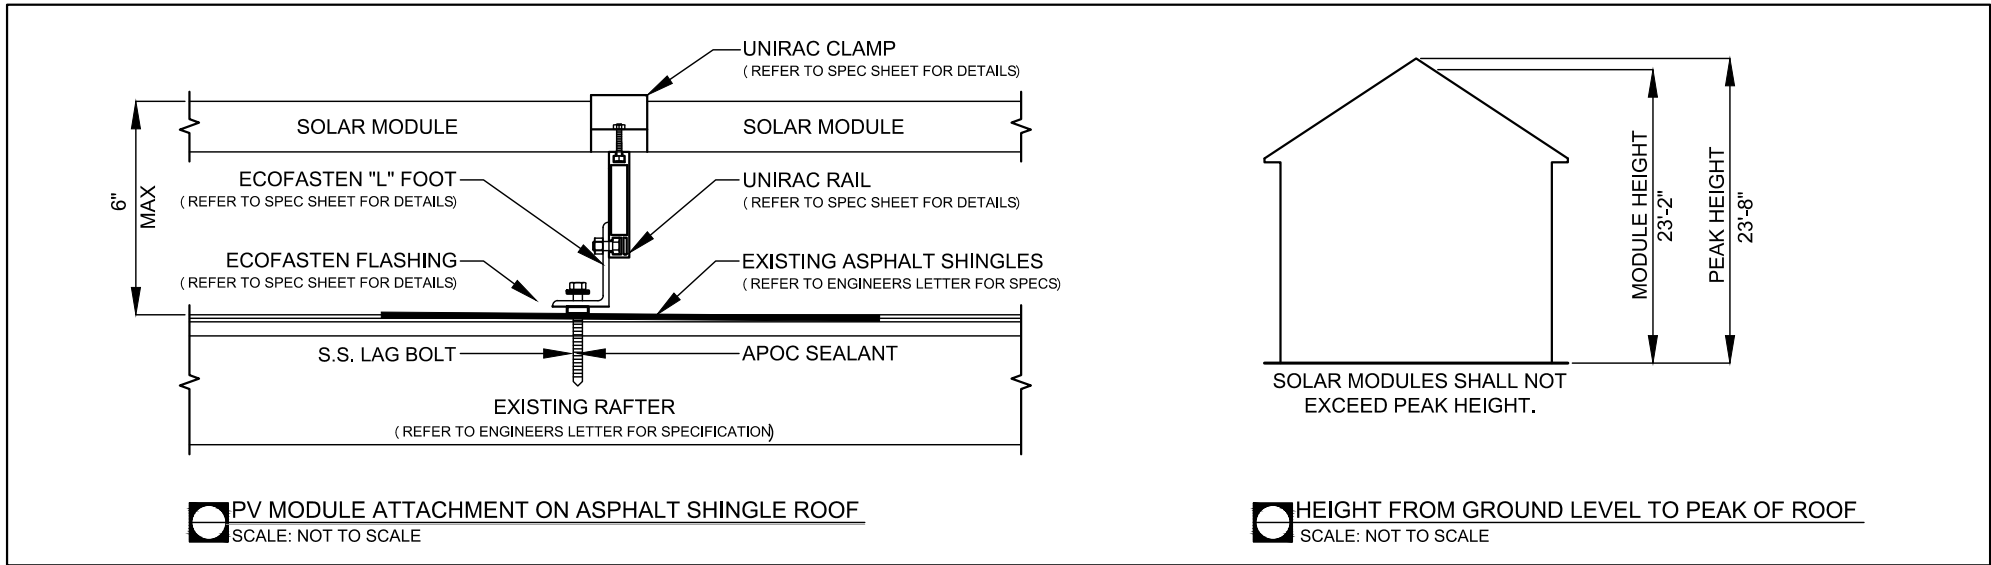

Engineer / License Holder:
Nicolas A. Nitti, P.E.
N.Y. P.E. LIC. # 091373
100 Great Oaks Boulevard
Albany, NY 12203
(518) 313-7153
nnitti@westshorede.com

Issued / Revisions		
NO.	DESCRIPTION	DATE
A1	AS BUILT	9/5/2018
P1	ISSUED TO TOWNSHIP FOR PERMIT	6/18/2018

Project Title:

REID, TRAVIS
TRINITY ACCT #: 2018-05-260764

Project Address:

29 WELDON LN
PORT JEFFERSON STATION, NY 11776
40.929083,-73.056771
SCTM: 0200-160.00-04.00-006.000

Drawing Title:

AS BUILT PV SOLAR SYSTEM

Drawing Information	
DRAWING DATE:	6/18/2018
DRAWN BY:	IG
REVISED BY:	JMS

System Information:	
DC SYSTEM SIZE:	7.67kW
AC SYSTEM SIZE:	6kW
TOTAL MODULE COUNT:	26
MODULES USED:	HANWHA 295
MODULE SPEC #:	Q.PEAK-BLK G4.1 295
UTILITY COMPANY:	PSEG-LI
UTILITY ACCT #:	8561019504
UTILITY METER #:	42437072
DEAL TYPE:	SUNNOVA

Rev. No.	Sheet
A1	PV - 3

2211 Allenwood Road
Wall, New Jersey 07719

877-786-7283
www.Trinity-Solar.com

ARRAY CIRCUIT WIRING NOTES

1.) LICENSED ELECTRICIAN ASSUMES ALL RESPONSIBILITY FOR DETERMINING ONSITE CONDITIONS AND EXECUTING INSTALLATION IN ACCORDANCE WITH NEC 2014

2.) LOWEST EXPECTED AMBIENT TEMPERATURE BASED ON ASHRAE MINIMUM MEAN EXTREME DRY BULB TEMPERATURE FOR ASHRAE LOCATION MOST SIMILAR TO INSTALLATION LOCATION. LOWEST EXPECTED AMBIENT TEMP = -16°C

3.) HIGHEST CONTINUOUS AMBIENT TEMPERATURE BASED ON ASHRAE HIGHEST MONTH 2% DRY BULB TEMPERATURE FOR ASHRAE LOCATION MOST SIMILAR TO INSTALLATION LOCATION. HIGHEST CONTINUOUS TEMP = 33°C

4.) 2005 ASHRAE FUNDAMENTALS 2% DESIGN TEMPERATURES DO NOT EXCEED 47°C IN THE UNITED STATES (PALM SPRINGS, CA IS 44.1°C). FOR LESS THAN 9 CURRENT-CARRYING CONDUCTORS IN A ROOF-MOUNTED SUNLIT CONDUIT AT LEAST 0.5" ABOVE ROOF AND USING THE OUTDOOR DESIGN TEMPERATURE OF 47°C OR LESS (ALL OF UNITED STATES)

5.) PV SYSTEM CIRCUITS INSTALLED ON OR IN BUILDINGS SHALL INCLUDE A RAPID SHUTDOWN FUNCTION THAT CONTROLS SPECIFIC CONDUCTORS IN ACCORDANCE WITH NEC 690.12(1) THROUGH (5)

6.) PHOTOVOLTAIC POWER SYSTEMS SHALL BE PERMITTED TO OPERATE WITH UNGROUNDED PHOTOVOLTAIC SOURCE AND OUTPUT CIRCUIT AS PER NEC 690.35

7.) UNGROUNDED DC CIRCUIT CONDUCTORS SHALL BE IDENTIFIED WITH THE FOLLOWING OUTER FINISH:
POSITIVE CONDUCTORS = RED
NEGATIVE CONDUCTORS = BLACK
NEC 210.5(C)(2)

8.) ARRAY AND SUB ARRAY CONDUCTORS SHALL BE #10 PV WIRE TYPE RHW-2 OR EQUIVELANT AND SHALL BE PROTECTED BY CONDUIT WHERE EXPOSED TO DIRECT SUNLIGHT. SUB ARRAY CONDUIT LONGER THAN 24" SHALL CONTAIN ≤ 20 CURRENT CARRYING CONDUCTORS AND WHERE EXPOSED TO DIRECT SUNLIGHT SHALL CONTAIN ≤ 9 CURRENT CARRYING CONDUCTORS.

9.) ALL WIRE LENGTHS SHALL BE LESS THAN 100' UNLESS OTHERWISE NOTED

10.) FLEXIBLE CONDUIT SHALL NOT BE INSTALLED ON ROOFTOP AND SHALL BE LIMITED TO 12" IF USED OUTDOORS

11.) OVERCURRENT PROTECTION FOR CONDUCTORS CONNECTED TO THE SUPPLY SIDE OF A SERVICE SHALL BE LOCATED WITHIN 10' OF THE POINT OF CONNECTION NEC 705.31

12.) WHERE TWO SOURCES FEED A BUSSBAR, ONE A UTILITY AND THE OTHER AN INVERTER, PV BACKFEED BREAKER(S) SHALL BE LOCATED OPPOSITE FROM UTILITY NEC 705.12(D)(2)(3)(b)

13.) ALL SOLAR SYSTEM LOAD CENTERS TO CONTAIN ONLY GENERATION CIRCUITS AND NO UNUSED POSITIONS OR LOADS

14.) ALL EQUIPMENT INSTALLED OUTDOORS SHALL HAVE A NEMA 3R RATING

CALCULATIONS FOR CURRENT CARRYING CONDUCTORS
REQUIRED CONDUCTOR AMPACITY PER STRING
[NEC 690.8(B)(1)]: (15.00*1.25)1 = 18.75A

AWG #10, DERATED AMPACITY
AMBIENT TEMP: 33°C, TEMP DERATING FACTOR: .96
RACEWAY DERATING = 4 CCC: 0.80
(40*.96)0.80 = 30.72A


30.72A ≥ 18.75A, THEREFORE WIRE SIZE IS VALID

TOTAL AC REQUIRED CONDUCTOR AMPACITY
25.00A*1.25 = 31.25A

AWG #8, DERATED AMPACITY
AMBIENT TEMP: 30°C, TEMP DERATING: 1.0
RACEWAY DERATING ≤ 3 CCC: N/A
55A*1.0 = 55A

55A ≥ 31.25A, THEREFORE AC WIRE SIZE IS VALID

CALCULATION FOR PV OVERCURRENT PROTECTION
TOTAL INVERTER CURRENT: 25.00A
25.00A*1.25 = 31.25A
--> 40A OVERCURRENT PROTECTION IS VALID

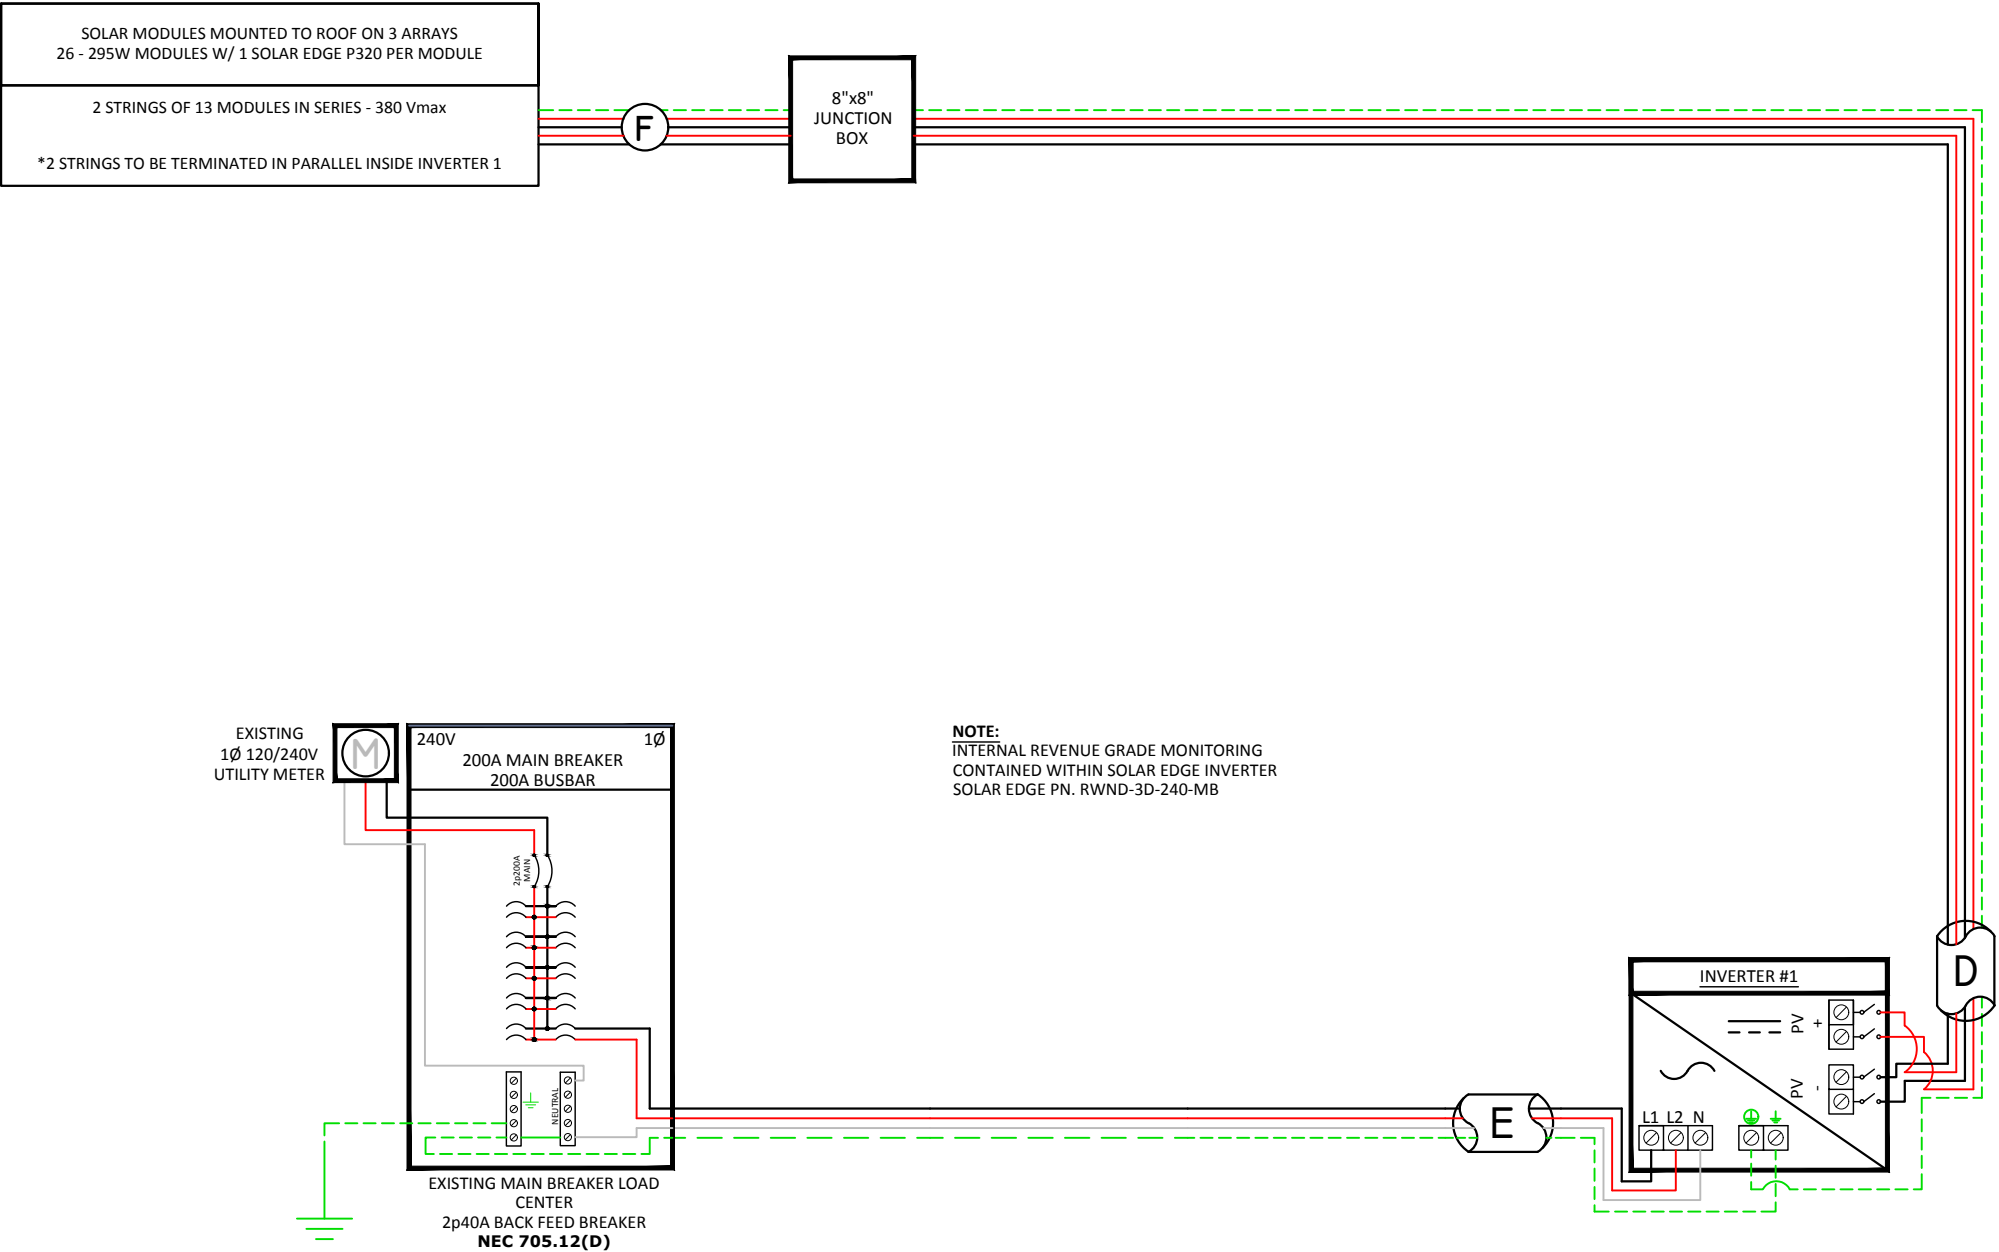

PV MODULE SPECIFICATIONS	
HANWHA 295 (Q.PEAK-BLK G4.1 295)	
Imp	9.17
Vmp	32.19
Voc	39.48
Isc	9.7

INVERTER #1 - SE6000H-US000NNC2			
DC		AC	
Imp	18	Pout	6000
Vmp	380	Imax	25
Voc	480	OCPDmin	31.25
Isc	30	Vnom	240


NOTE: CONDUIT TYPE SHALL BE CHOSEN BY THE INSTALLATION CONTRACTOR TO MEET OR EXCEED NEC AND LOCAL AHJD REQUIREMENTS

A	#6 THWN-2 GEC TO EXISTING GROUND ROD
B	1" CONDUIT W/ 2-#8 THWN-2, 1-#10 THWN-2, 1-#10 THWN-2 GROUND
C	1" CONDUIT W/ 4-#10 THWN-2, 1-#10 THWN-2 GROUND
D	1" CONDUIT W/ 4-#10 THWN-2, 1-#10 THWN-2 GROUND
E	1" CONDUIT W/ 2-#8 THWN-2, 1-#10 THWN-2, 1-#10 THWN-2 GROUND
F	#10 PV WIRE (FREE AIR) W/ #6 BARE COPPER BOND TO ARRAY

Engineer / License Holder:

Nicolas A. Nitti, P.E.

N.Y. P.E. LIC. # 091373
100 Great Oaks Boulevard
Albany, NY 12203
(518) 313-7153
nnitti@westshorede.com

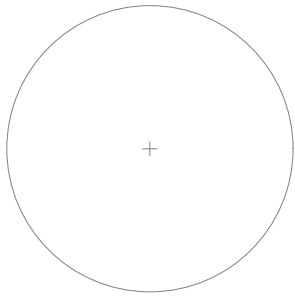

Issued / Revisions

A1	AS BUILT	9/5/2018
P1	ISSUED TO TOWNSHIP FOR PERMIT	6/18/2018
NO.	DESCRIPTION	DATE

Project Title:

REID, TRAVIS
TRINITY ACCT #: 2018-05-260764

Project Address:

29 WELDON LN
PORT JEFFERSON STATION, NY 11776
40.929083,-73.056771
SCTM: 0200-160.00-04.00-006.000

Drawing Title:

AS BUILT PV SOLAR SYSTEM

Drawing Information	
DRAWING DATE:	6/18/2018
DRAWN BY:	IG
REVISED BY:	JMS

System Information:	
DC SYSTEM SIZE:	7.67kW
AC SYSTEM SIZE:	6kW
TOTAL MODULE COUNT:	26
MODULES USED:	HANWHA 295
MODULE SPEC #:	Q.PEAK-BLK G4.1 295
UTILITY COMPANY:	PSEG-LI
UTILITY ACCT #:	8561019504
UTILITY METER #:	42437072
DEAL TYPE:	SUNNOVA

Rev. No.	Sheet
A1	PV - 4



2211 Allenwood Road
Wall, New Jersey 07719
877-786-7283
www.Trinity-Solar.com