
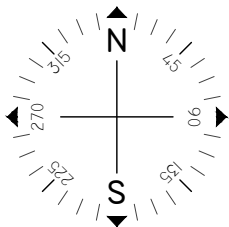


# INSTALLATION OF NEW ROOF MOUNTED PV SOLAR SYSTEM

77 NEW AMWELL RD  
HILLSBOROUGH, NJ 08844

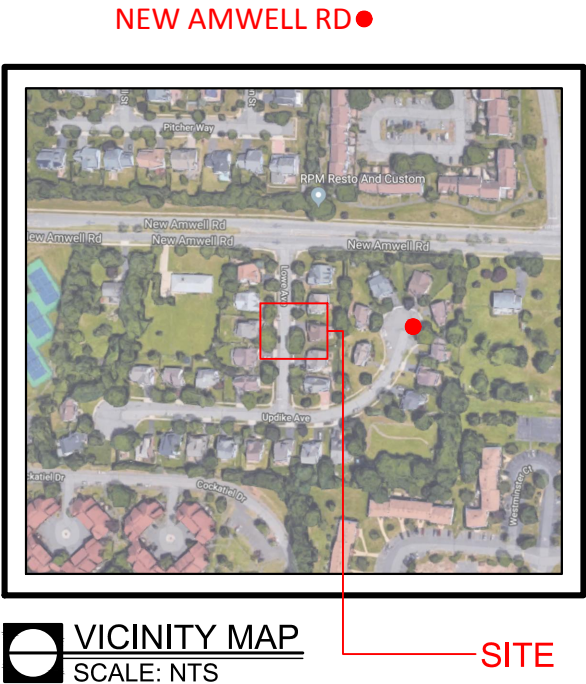

#### Issued / Revisions

A1	AS BUILT	7/10/2018
P1	ISSUED TO TOWNSHIP FOR PERMIT	5/31/2018
NO.	DESCRIPTION	DATE

Project Title:
FARYNIAK, JOHN-
TRINITY ACCT #: 2018-05-260270

Project Address:
77 NEW AMWELL RD HILLSBOROUGH, NJ 08844 40.506283,-74.656160

Drawing Title:
AS BUILT PV SOLAR SYSTEM

Drawing Information	
DRAWING DATE:	5/31/2018
DRAWN BY:	TL
REVISED BY:	JMS

System Information:	
DC SYSTEM SIZE:	12kW
AC SYSTEM SIZE:	10kW
TOTAL MODULE COUNT:	40
MODULES USED:	TRINA 300
MODULE SPEC #:	TSM-300 DD05A.05
UTILITY COMPANY:	PSE&G
UTILITY ACCT #:	7025024406
UTILITY METER #:	127228752
DEAL TYPE:	SUNNOVA

Rev. No.	Sheet
A1	PV - 1



2211 Allenwood Road  
Wall, New Jersey 07719

877-786-7283  
www.Trinity-Solar.com

#### GENERAL NOTES

1. THE INSTALLATION CONTRACTOR IS RESPONSIBLE FOR INSTALLING ALL EQUIPMENT AND FOLLOWING ALL DIRECTIONS AND INSTRUCTIONS CONTAINED IN THE DRAWING PACKAGE AND INFORMATION RECEIVED FROM TRINITY.
2. THE INSTALLATION CONTRACTOR IS RESPONSIBLE FOR INSTALLING ALL EQUIPMENT AND FOLLOWING ALL DIRECTIONS AND INSTRUCTION CONTAINED IN THE COMPLETE MANUAL.
3. THE INSTALLATION CONTRACTOR IS RESPONSIBLE FOR READING AND UNDERSTANDING ALL DRAWINGS, COMPONENT AND INVERTER MANUALS PRIOR TO INSTALLATION. THE INSTALLATION CONTRACTOR IS ALSO REQUIRED TO HAVE ALL COMPONENT SWITCHES IN THE OFF POSITION AND FUSES REMOVED PRIOR TO THE INSTALLATION OF ALL FUSE BEARING SYSTEM COMPONENTS.
4. ONCE THE PHOTOVOLTAIC MODULES ARE MOUNTED, THE INSTALLATION CONTRACTOR SHOULD HAVE A MINIMUM OF ONE ELECTRICIAN WHO HAS ATTENDED A SOLAR PHOTOVOLTAIC INSTALLATION COURSE ON SITE.
5. FOR SAFETY, IT IS RECOMMENDED THAT THE INSTALLATION CREW ALWAYS HAVE A MINIMUM OF TWO PERSONS WORKING TOGETHER AND THAT EACH OF THE INSTALLATION CREW MEMBERS BE TRAINED IN FIRST AID AND CPR.
6. THIS SOLAR PHOTOVOLTAIC SYSTEM IS TO BE INSTALLED FOLLOWING THE CONVENTIONS OF THE NATIONAL ELECTRICAL CODE. ANY LOCAL CODE WHICH MAY SUPERSEDE THE NEC SHALL GOVERN.
7. ALL SYSTEM COMPONENTS TO BE INSTALLED WITH THIS SYSTEM ARE TO BE "UL" LISTED. ALL EQUIPMENT WILL BE NEMA 3R OUTDOOR RATED UNLESS INDOORS.

#### GENERAL NOTES

IF ISSUED DRAWING IS MARKED WITH A REVISION CHARACTER OTHER THAN "A", PLEASE BE ADVISED THAT FINAL EQUIPMENT AND/OR SYSTEM CHARACTERISTICS ARE SUBJECT TO CHANGE DUE TO AVAILABILITY OF EQUIPMENT.

#### GENERAL NOTES CONTINUED

8. THE DC VOLTAGE FROM THE PANELS IS ALWAYS PRESENT AT THE DC DISCONNECT ENCLOSURE AND THE DC TERMINALS OF THE INVERTER DURING DAYLIGHT HOURS. ALL PERSONS WORKING ON OR INVOLVED WITH THE PHOTOVOLTAIC SYSTEM ARE WARNED THAT THE SOLAR MODULES ARE ENERGIZED WHENEVER THEY ARE EXPOSED TO LIGHT.
9. ALL PORTIONS OF THIS SOLAR PHOTOVOLTAIC SYSTEM SHALL BE MARKED CLEARLY IN ACCORDANCE WITH THE NATIONAL ELECTRICAL CODE ARTICLE 690 & 705.
10. PRIOR TO THE INSTALLATION OF THIS PHOTOVOLTAIC SYSTEM, THE INSTALLATION CONTRACTOR SHALL ATTEND A PRE-INSTALLTION MEETING FOR THE REVIEW OF THE INSTALLATION PROCEDURES, SCHEDULES, SAFETY AND COORDINATION.
11. PRIOR TO THE SYSTEM START UP THE INSTALLATION CONTRACTOR SHALL ASSIST IN PERFORMING ALL INITIAL HARDWARE CHECKS AND DC WIRING CONDUCTIVITY CHECKS.
12. FOR THE PROPER MAINTENANCE AND ISOLATION OF THE INVERTERS REFER TO THE ISOLATION PROCEDURES IN THE OPERATION MANUAL.
13. THE LOCATION OF PROPOSED ELECTRIC AND TELEPHONE UTILITIES ARE SUBJECT TO FINAL APPROVAL OF THE APPROPRIATE UTILITY COMPANIES AND OWNERS.
14. ALL MATERIALS, WORKMANSHIP AND CONSTRUCTION FOR THE SITE IMPROVEMENTS SHOWN HEREIN SHALL BE IN ACCORDANCE WITH:
  - A) CURRENT PREVAILING MUNICIPAL AND/OR COUNTY SPECIFICATIONS, STANDARDS AND REQUIREMENTS

#### GENERAL NOTES CONTINUED

14. B) CURRENT PREVAILING UTILITY COMPANY SPECIFICATIONS, STANDARDS, AND REQUIREMENTS
15. THIS SET OF PLANS HAVE BEEN PREPARED FOR THE PURPOSE OF MUNICIPAL AND AGENCY REVIEW AND APPROVAL. THIS SET OF PLANS SHALL NOT BE UTILIZED AS CONSTRUCTION DRAWINGS UNTIL REVISED TO INDICATE "ISSUED FOR CONSTRUCTION".
16. ALL INFORMATION SHOWN MUST BE CERTIFIED PRIOR TO USE FOR CONSTRUCTION ACTIVITIES.

#### ABBREVIATIONS

AMP	AMPERE
AC	ALTERNATING CURRENT
AL	ALUMINUM
AF	AMP. FRAME
AFF	ABOVE FINISHED FLOOR
AFG	ABOVE FINISHED GRADE
AWG	AMERICAN WIRE GAUGE
C	CONDUIT ( GENERIC TERM OF SPECIFIED)
CB	COMBINER BOX
CKT	CIRCUIT
CT	CURRENT TRANSFORMER
CU	COPPER
DC	DIRECT CURRENT
DISC	DISCONNECT SWITCH
DWG	DRAWING
EC	ELECTRICAL SYSTEM INSTALLER
EMT	ELECTRICAL METALLIC TUBING
FS	FUSIBLE SWITCH
FU	FUSE
GND	GROUND
GFI	GROUND FAULT INTERRUPTER
HZ	FREQUENCY ( CYCLES PER SECOND)


#### ABBREVIATIONS CONTINUED

JB	JUNCTION BOX
kCMIL	THOUSAND CIRCULAR MILS
kVA	KILO-VOLT AMPERE
kW	KILO-WATT
kWH	KILO-WATT HOUR
L	LINE
MCB	MAIN CIRCUIT BREAKER
MDP	MAIN DISTRIBUTION PANEL
MLO	MAIN LUG ONLY
MTD	MOUNTED
MTG	MOUNTING
N	NEUTRAL
NEC	NATIONAL ELECTRICAL CODE
NIC	NOT IN CONTRACT
NO #	NUMBER
NTS	NOT TO SCALE
OCP	OVER CURRENT PROTECTION
P	POLE
PB	PULL BOX
PH Ø	PHASE
PVC	POLY-VINYL CHLORIDE CONDUIT
PWR	POWER
QTY	QUANTITY
RGS	RIGID GALVANIZED STEEL
SN	SOLID NEUTRAL
JSWBD	SWITCHBOARD
TYP	TYPICAL
U.O.I.	UNLESS OTHERWISE INDICATED
WP	WEATHERPROOF
XFMR	TRANSFORMER
+72	MOUNT 72 INCHES TO BOTTOM OF ABOVE FINISHED FLOOR OR GRADE


#### SHEET INDEX

PV-1	COVER SHEET W/ SITE INFO & NOTES
PV-2	ROOF PLAN W/ MODULE LOCATIONS
PV-3	ELECTRICAL 3 LINE DIAGRAM
AP	APPENDIX


NOTES : \*REFER TO MODULE SPECS FOR MODULE DIMENSIONS  
\*DEPICTED MODULES MAY BE PORTRAIT OR LANDSCAPE

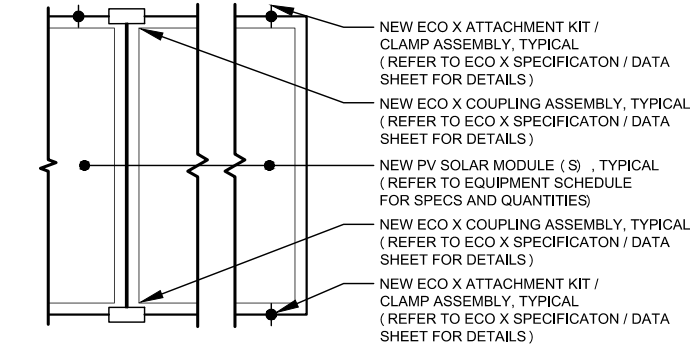


**ATTACHMENT & CLIP DETAIL**  
SCALE: NOT TO SCALE

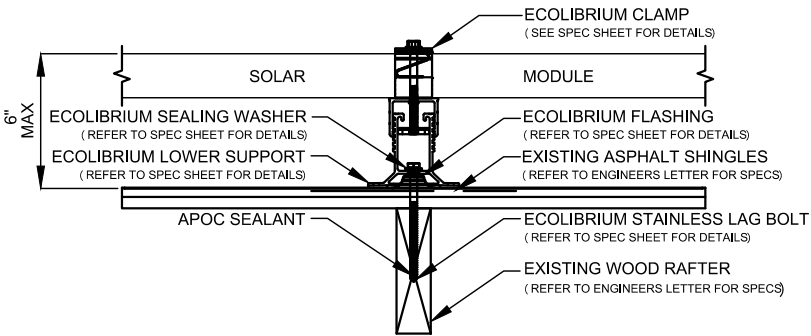

**PV MODULE ATTACHMENT ON ASPHALT SHINGLE ROOF**  
SCALE: NOT TO SCALE

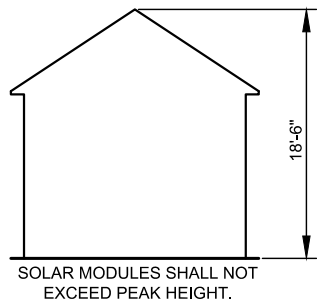

**HEIGHT FROM GROUND LEVEL TO PEAK OF ROOF**  
SCALE: NOT TO SCALE

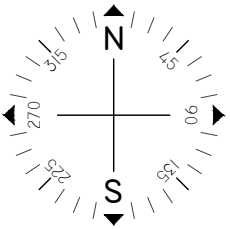

ARRAY SCHEDULE

ROOF 1  
MODULES: 0  
PITCH: 23°  
ORIENTATION: 2°

ROOF 2  
MODULES: 31  
PITCH: 21°  
ORIENTATION: 182°

ROOF 3  
MODULES: 0  
PITCH: 23°  
ORIENTATION: 3°

ROOF 4  
MODULES: 9  
PITCH: 18°  
ORIENTATION: 183°

ROOF 5  
MODULES: 0  
PITCH: 4°  
ORIENTATION: 183°

ROOF 6  
MODULES: 0  
PITCH: 23°  
ORIENTATION: 94°

ROOF 7  
MODULES: 0  
PITCH: 23°  
ORIENTATION: 274°

NOTES:

DESIGN CRITERIA:  
WINDSPEED: 115mph (3 SEC. GUST)  
SITE CATEGORY: C  
CODE: N.J. I.R.C. 201

- 1.) ALL EQUIPMENT SHALL BE INSTALLED IN ACCORDANCE WITH THE MANUFACTURER'S INSTALLATION INSTRUCTIONS.
- 2.) ARRAY BONDING TO COMPLY WITH MANUFACTURER SPECIFICATION.
- 3.) ALL LOCATIONS ARE APPROXIMATE AND REQUIRE FIELD VERIFICATION.
- 4.) AN AC DISCONNECT SHALL BE GROUPED WITH INVERTER (S) . NEC 690.13 (E) .
- 5.) ALL OUTDOOR EQUIPMENT SHALL BE RAIN TIGHT WITH MINIMUM NEMA 3R RATING.
- 6.) ROOFTOP SOLAR INSTALLATION ONLY PV ARRAY SHALL NOT EXTEND BEYOND THE EXISTING ROOF EDGE.

SYMBOL LEGEND



	INDICATES ROOF DESIGNATION . REFER TO ARRAY SCHEDULE FOR MORE INFORMATION		INDICATES NEW UTILITY DISCONNECT TO BE INSTALLED OUTSIDE		INDICATES NEW PV ONLY SUBPANEL TO BE INSTALLED
	INDICATES EXISTING METER LOCATION		INDICATES NEW PV SOLAR MODULE. <b>RED</b> MODULES INDICATE PANELS THAT USE MICRO INVERTERS. REFER TO EQUIPMENT SCHEDULE FOR SPECS.		
	INDICATES EXISTING ELECTRICAL PANEL LOCATION: INSIDE		INDICATES NEW PRODUCTION METER TO BE INSTALLED OUTSIDE.		
	INDICATES NEW FUSED PV DISCONNECT TO BE INSTALLED INSIDE		INDICATES NEW INVERTER TO BE INSTALLED OUTSIDE. REFER TO EQUIPMENT SCHEDULE FOR SPECS.		

PLUMBING SCHEDULE

OTHER OBSTRUCTIONS	

EQUIPMENT SCHEDULE

QTY	SPEC #
40	TRINA 300 (TSM-300 DD05A.05)
1	SE10000A-US000NNR2

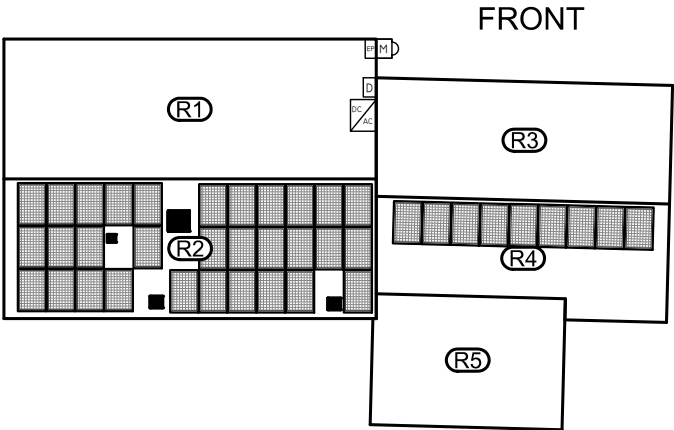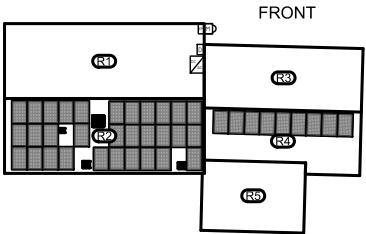

Issued / Revisions

NO.	DESCRIPTION	DATE
A1	AS BUILT	7/10/2018
P1	ISSUED TO TOWNSHIP FOR PERMIT	5/31/2018

Project Title:

FARYNIAK, JOHN-  
TRINITY ACCT #: 2018-05-260270

Project Address:

77 NEW AMWELL RD  
HILLSBOROUGH, NJ 08844  
40.506283,-74.656160

Drawing Title:

AS BUILT PV SOLAR SYSTEM

Drawing Information

DRAWING DATE:	5/31/2018
DRAWN BY:	TL
REVISED BY:	JMS

System Information:

DC SYSTEM SIZE:	12kW
AC SYSTEM SIZE:	10kW
TOTAL MODULE COUNT:	40
MODULES USED:	TRINA 300
MODULE SPEC #:	TSM-300 DD05A.05
UTILITY COMPANY:	PSE&G
UTILITY ACCT #:	7025024406
UTILITY METER #:	127228752
DEAL TYPE:	SUNNOVA

Rev. No.

A1

Sheet

PV - 2



2211 Allenwood Road  
Wall, New Jersey 07719

877-786-7283  
www.Trinity-Solar.com

ARRAY CIRCUIT WIRING NOTES

1.) LICENSED ELECTRICIAN ASSUMES ALL RESPONSIBILITY FOR DETERMINING ONSITE CONDITIONS AND EXECUTING INSTALLATION IN ACCORDANCE WITH NEC 2014

2.) LOWEST EXPECTED AMBIENT TEMPERATURE BASED ON ASHRAE MINIMUM MEAN EXTREME DRY BULB TEMPERATURE FOR ASHRAE LOCATION MOST SIMILAR TO INSTALLATION LOCATION. LOWEST EXPECTED AMBIENT TEMP = -16°C

3.) HIGHEST CONTINUOUS AMBIENT TEMPERATURE BASED ON ASHRAE HIGHEST MONTH 2% DRY BULB TEMPERATURE FOR ASHRAE LOCATION MOST SIMILAR TO INSTALLATION LOCATION. HIGHEST CONTINUOUS TEMP = 33°C

4.) 2005 ASHRAE FUNDAMENTALS 2% DESIGN TEMPERATURES DO NOT EXCEED 47°C IN THE UNITED STATES (PALM SPRINGS, CA IS 44.1°C). FOR LESS THAN 9 CURRENT-CARRYING CONDUCTORS IN A ROOF-MOUNTED SUNLIT CONDUIT AT LEAST 0.5" ABOVE ROOF AND USING THE OUTDOOR DESIGN TEMPERATURE OF 47°C OR LESS (ALL OF UNITED STATES)

5.) PV SYSTEM CIRCUITS INSTALLED ON OR IN BUILDINGS SHALL INCLUDE A RAPID SHUTDOWN FUNCTION THAT CONTROLS SPECIFIC CONDUCTORS IN ACCORDANCE WITH NEC 690.12(1) THROUGH (5)

6.) PHOTOVOLTAIC POWER SYSTEMS SHALL BE PERMITTED TO OPERATE WITH UNGROUNDED PHOTOVOLTAIC SOURCE AND OUTPUT CIRCUIT AS PER NEC 690.35

7.) UNGROUNDED DC CIRCUIT CONDUCTORS SHALL BE IDENTIFIED WITH THE FOLLOWING OUTER FINISH: POSITIVE CONDUCTORS = RED NEGATIVE CONDUCTORS = BLACK NEC 210.5(C)(2)

8.) ARRAY AND SUB ARRAY CONDUCTORS SHALL BE #10 PV WIRE TYPE RHW-2 OR EQUIVELANT AND SHALL BE PROTECTED BY CONDUIT WHERE EXPOSED TO DIRECT SUNLIGHT. SUB ARRAY CONDUIT LONGER THAN 24" SHALL CONTAIN ≤ 20 CURRENT CARRYING CONDUCTORS AND WHERE EXPOSED TO DIRECT SUNLIGHT SHALL CONTAIN ≤ 9 CURRENT CARRYING CONDUCTORS.

9.) ALL WIRE LENGTHS SHALL BE LESS THAN 100' UNLESS OTHERWISE NOTED

10.) FLEXIBLE CONDUIT SHALL NOT BE INSTALLED ON ROOFTOP AND SHALL BE LIMITED TO 12" IF USED OUTDOORS

11.) OVERCURRENT PROTECTION FOR CONDUCTORS CONNECTED TO THE SUPPLY SIDE OF A SERVICE SHALL BE LOCATED WITHIN 10' OF THE POINT OF CONNECTION NEC 705.31

12.) WHERE TWO SOURCES FEED A BUSSBAR, ONE A UTILITY AND THE OTHER AN INVERTER, PV BACKFEED BREAKER(S) SHALL BE LOCATED OPPOSITE FROM UTILITY NEC 705.12(D)(2)(3)(b)

13.) ALL SOLAR SYSTEM LOAD CENTERS TO CONTAIN ONLY GENERATION CIRCUITS AND NO UNUSED POSITIONS OR LOADS

14.) ALL EQUIPMENT INSTALLED OUTDOORS SHALL HAVE A NEMA 3R RATING

CALCULATIONS FOR CURRENT CARRYING CONDUCTORS REQUIRED CONDUCTOR AMPACITY PER STRING [NEC 690.8(B)(1)]: (15.00\*1.25)1 = 18.75A

AWG #10, DERATED AMPACITY AMBIENT TEMP: 33°C, TEMP DERATING FACTOR: .96 RACEWAY DERATING = 6 CCC: 0.80 (40\*.96)0.80 = 30.72A


30.72A ≥ 18.75A, THEREFORE WIRE SIZE IS VALID

TOTAL AC REQUIRED CONDUCTOR AMPACITY 42.00A\*1.25 = 52.50A

AWG #6, DERATED AMPACITY AMBIENT TEMP: 30°C, TEMP DERATING: 1.0 RACEWAY DERATING ≤ 3 CCC: N/A 75A\*1.0 = 75A

75A ≥ 52.50A, THEREFORE AC WIRE SIZE IS VALID

CALCULATION FOR PV OVERCURRENT PROTECTION TOTAL INVERTER CURRENT: 42.00A 42.00A\*1.25 = 52.50A --> 60A OVERCURRENT PROTECTION IS VALID

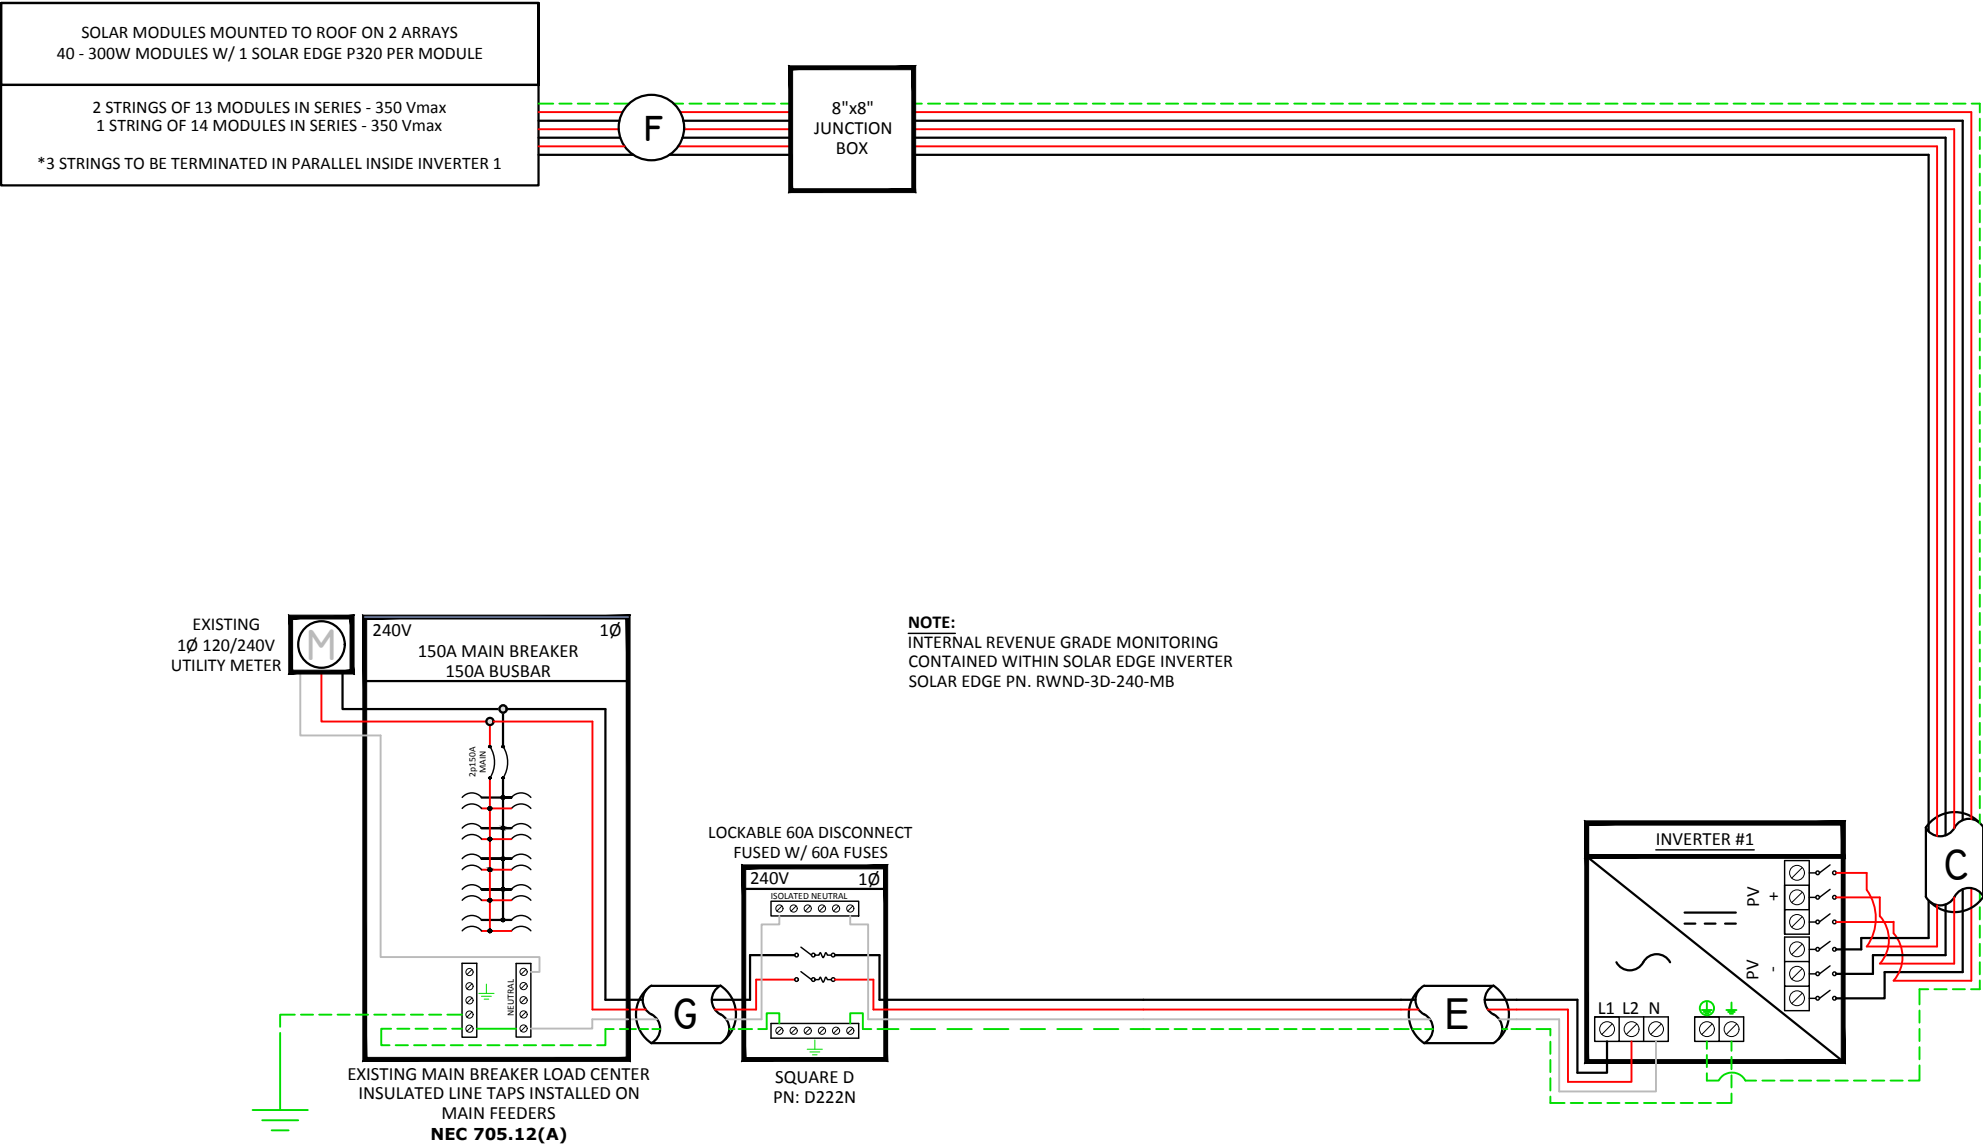


PV MODULE SPECIFICATIONS	
TRINA 300 (TSM-300 DD05A.05)	
Imp	9.19
Vmp	32.6
Voc	39.8
Isc	9.77

INVERTER #1 - SE10000A-US000NNR2			
DC		AC	
Imp	30.5	Pout	10000
Vmp	350	Imax	42
Voc	500	OCpDmin	52.5
Isc	45	Vnom	240

NOTE: CONDUIT TYPE SHALL BE CHOSEN BY THE INSTALLATION CONTRACTOR TO MEET OR EXCEED NEC AND LOCAL AHJD REQUIREMENTS

A	#6 THWN-2 GEC TO EXISTING GROUND ROD
B	3/4" CONDUIT W/ 2-#6 THWN-2, 1-#10 THWN-2, 1-#10 THWN-2 GROUND
C	3/4" CONDUIT W/ 6-#10 THWN-2, 1-#10 THWN-2 GROUND
D	3/4" CONDUIT W/ 6-#10 THWN-2, 1-#10 THWN-2 GROUND
E	3/4" CONDUIT W/ 2-#6 THWN-2, 1-#10 THWN-2, 1-#10 THWN-2 GROUND
F	#10 PV WIRE (FREE AIR) W/ #6 BARE COPPER BOND TO ARRAY
G	3/4" CONDUIT W/ 2-#6 THWN-2, 1-#6 THWN-2, 1-#8 THWN-2 GROUND

Engineer / License Holder:

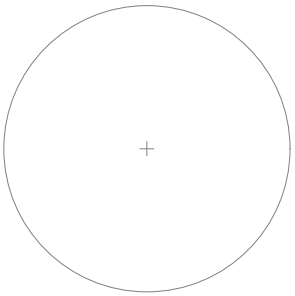

Issued / Revisions

NO.	DESCRIPTION	DATE
A1	AS BUILT	7/10/2018
P1	ISSUED TO TOWNSHIP FOR PERMIT	5/31/2018

Project Title:  
FARYNIAK, JOHN-  
TRINITY ACCT #: 2018-05-260270

Project Address:  
77 NEW AMWELL RD  
HILLSBOROUGH, NJ 08844  
40.506283,-74.656160

Drawing Title:  
AS BUILT PV SOLAR SYSTEM

Drawing Information  
DRAWING DATE: 5/31/2018  
DRAWN BY: TL  
REVISED BY: JMS

System Information:  
DC SYSTEM SIZE: 12kW  
AC SYSTEM SIZE: 10kW  
TOTAL MODULE COUNT: 40  
MODULES USED: TRINA 300  
MODULE SPEC #: TSM-300 DD05A.05  
UTILITY COMPANY: PSE&G  
UTILITY ACCT #: 7025024406  
UTILITY METER #: 127228752  
DEAL TYPE: SUNNOVA

Rev. No. A1  
Sheet PV - 3



2211 Allenwood Road Wall, New Jersey 07719 877-786-7283 www.Trinity-Solar.com

# APPLICATIONS CHANGE

(FOR INTERNAL USE ONLY)

☐ UPDATE ☐ REVISION

BUILDING

ZONING REQUIRED?

☐ YES ☐ NO

☐ UPDATE ☐ REVISION

ELECTRICAL

- ☐ REVISED LAYOUT
- ☐ REVISED ENGINEER LETTER
- ☐ ADD \_\_\_\_ PANELS
- ☐ REMOVE \_\_\_\_ PANELS
- ☐ RELOCATING PANELS
- ☒ CHANGE RACKING

## BUILDING NOTE:

-UNIRAC RAILLESS TO ECO-X

## ELECTRICAL NOTE:

-REMOVED UNFUSED DISCO

## ZONING NOTE:

-

- ☐ SYSTEM SIZE INCREASE
- ☐ SYSTEM SIZE DECREASE
- ☐ ADD TAP BOX \$100
- ☐ ADD SUBPANEL \$150
- ☐ NEW METER PAN \$100
- ☐ NEW RISER \$100
- ☐ NEW MAIN PANEL \$800  
( includes meter pan and riser)
- ☐ ADD INVERTER \$150
- ☐ ADD \_\_\_\_ AMP FUSED DISCONNECT \$50
- ☐ ADD \_\_\_\_ AMP BREAKER
- ☐ ADD BREAKER ENCLOSURE \$100
- ☐ ADD UNFUSED DISCONNECT \$100
- ☒ REMOVE UNFUSED DISCONNECT
- ☐ REMOVE FUSED DISCONNECT
- ☐ CHANGE POINT OF INTERCONNECTION
- ☐ CHANGE METHOD OF INTERCONNECTION
- ☐ REMOVE PRODUCTION METER
- ☐ ADD PRODUCTION METER
- ☐ DECREASE FUSE SIZE
- ☐ INCREASE FUSE SIZE
- ☐ INVERTER SIZE DECREASE
- ☐ INVERTER SIZE INCREASE