

INSTALLATION OF NEW
ROOF MOUNTED PV SOLAR SYSTEM
405 ELMORE ST
CENTRAL ISLIP, NY 11722

PLAN REVIEW NOTICE

TOWN OF ISLIP BUILDING EXAMINER SHALL REVIEW THE ENCLOSED DOCUMENT FOR MINIMUM ACCEPTABLE PLAN SUBMITTAL REQUIREMENTS OF THE TOWN OF ISLIP AS SPECIFIED IN THE BUILDING AND/OR RESIDENTIAL CODE OF THE STATE OF NEW YORK. THIS REVIEW DOES NOT GUARANTEE COMPLIANCE WITH THAT CODE. THE SEAL AND SIGNATURE OF THE DESIGN PREFESSIONAL HAS BEEN INTERPRETED AS AN ATTESTATION THAT, TO THE BEST OF THE LICENSEE'S BELIEF AND INFORMATION, THE WORK IN THIS DOCUMENT:

- IS ACCURATE,
- CONFORMS WITH GOVERNING CODES APPLICABLE AT THE TIME OF SUBMISSION,
- CONFORMS WITH REASONABLE STANDARDS OF PRACTICE AND WITH VIEW TO THE SAFEGUARDING OF LIFE, HEALTH, PROPERTY AND PUBLIC WELFARE,
- IS THE RESPONSIBLY OF THE LICENSEE.

GENERAL NOTES

1. THE INSTALLATION CONTRACTOR IS RESPONSIBLE FOR INSTALLING ALL EQUIPMENT AND FOLLOWING ALL DIRECTIONS AND INSTRUCTIONS CONTAINED IN THE DRAWING PACKAGE AND INFORMATION RECEIVED FROM TRINITY.
2. THE INSTALLATION CONTRACTOR IS RESPONSIBLE FOR INSTALLING ALL EQUIPMENT AND FOLLOWING ALL DIRECTIONS AND INSTRUCTION CONTAINED IN THE COMPLETE MANUAL.
3. THE INSTALLATION CONTRACTOR IS RESPONSIBLE FOR READING AND UNDERSTANDING ALL DRAWINGS, COMPONENT AND INVERTER MANUALS PRIOR TO INSTALLATION. THE INSTALLATION CONTRACTOR IS ALSO REQUIRED TO HAVE ALL COMPONENT SWITCHES IN THE OFF POSITION AND FUSES REMOVED PRIOR TO THE INSTALLATION OF ALL FUSE BEARING SYSTEM COMPONENTS.
4. ONCE THE PHOTOVOLTAIC MODULES ARE MOUNTED, THE INSTALLATION CONTRACTOR SHOULD HAVE A MINIMUM OF ONE ELECTRICIAN WHO HAS ATTENDED A SOLAR PHOTOVOLTAIC INSTALLATION COURSE ON SITE.
5. FOR SAFETY, IT IS RECOMMENDED THAT THE INSTALLATION CREW ALWAYS HAVE A MINIMUM OF TWO PERSONS WORKING TOGETHER AND THAT EACH OF THE INSTALLATION CREW MEMBERS BE TRAINED IN FIRST AID AND CPR.
6. THIS SOLAR PHOTOVOLTAIC SYSTEM IS TO BE INSTALLED FOLLOWING THE CONVENTIONS OF THE NATIONAL ELECTRICAL CODE. ANY LOCAL CODE WHICH MAY SUPERSEDE THE NEC SHALL GOVERN.
7. ALL SYSTEM COMPONENTS TO BE INSTALLED WITH THIS SYSTEM ARE TO BE "UL" LISTED. ALL EQUIPMENT WILL BE NEMA 3R OUTDOOR RATED UNLESS INDOORS.

GENERAL NOTES CONTINUED

8. THE DC VOLTAGE FROM THE PANELS IS ALWAYS PRESENT AT THE DC DISCONNECT ENCLOSURE AND THE DC TERMINALS OF THE INVERTER DURING DAYLIGHT HOURS. ALL PERSONS WORKING ON OR INVOLVED WITH THE PHOTOVOLTAIC SYSTEM ARE WARNED THAT THE SOLAR MODULES ARE ENERGIZED WHENEVER THEY ARE EXPOSED TO LIGHT.
9. ALL PORTIONS OF THIS SOLAR PHOTOVOLTAIC SYSTEM SHALL BE MARKED CLEARLY IN ACCORDANCE WITH THE NATIONAL ELECTRICAL CODE ARTICLE 690 & 705.
10. PRIOR TO THE INSTALLATION OF THIS PHOTOVOLTAIC SYSTEM, THE INSTALLATION CONTRACTOR SHALL ATTEND A PRE-INSTALLTION MEETING FOR THE REVIEW OF THE INSTALLATION PROCEDURES, SCHEDULES, SAFETY AND COORDINATION.
11. PRIOR TO THE SYSTEM START UP THE INSTALLATION CONTRACTOR SHALL ASSIST IN PERFORMING ALL INITIAL HARDWARE CHECKS AND DC WIRING CONDUCTIVITY CHECKS.
12. FOR THE PROPER MAINTENANCE AND ISOLATION OF THE INVERTERS REFER TO THE ISOLATION PROCEDURES IN THE OPERATION MANUAL.
13. THE LOCATION OF PROPOSED ELECTRIC AND TELEPHONE UTILITIES ARE SUBJECT TO FINAL APPROVAL OF THE APPROPRIATE UTILITY COMPANIES AND OWNERS.
14. ALL MATERIALS, WORKMANSHIP AND CONSTRUCTION FOR THE SITE IMPROVEMENTS SHOWN HEREIN SHALL BE IN ACCORDANCE WITH:
 - A) CURRENT PREVAILING MUNICIPAL AND/OR COUNTY SPECIFICATIONS, STANDARDS AND REQUIREMENTS

GENERAL NOTES CONTINUED

14. B) CURRENT PREVAILING UTILITY COMPANY SPECIFICATIONS, STANDARDS, AND REQUIREMENTS
15. THIS SET OF PLANS HAVE BEEN PREPARED FOR THE PURPOSE OF MUNICIPAL AND AGENCY REVIEW AND APPROVAL. THIS SET OF PLANS SHALL NOT BE UTILIZED AS CONSTRUCTION DRAWINGS UNTIL REVISED TO INDICATE "ISSUED FOR CONSTRUCTION".
16. ALL INFORMATION SHOWN MUST BE CERTIFIED PRIOR TO USE FOR CONSTRUCTION ACTIVITIES.

2017 NOTES

- PV INSTALLATION TO COMPLY WITH THE FOLLOWING PUBLICATIONS:
- 2017 NEW YORK STATE UNIFORM CODE
 - 2015 INTERNATIONAL RESIDENTIAL CODE
 - 2ND PRINTING, AS AMENDED BY THE 2017 NEW YORK STATE UNIFORM CODE SUPPLEMENT
 - 2015 INTERNATIONAL ENERGY CONSERVATION CODE
 - TOWN OF ISLIP CODE
 - 2014 NATIONAL ELECTRICAL CODE

ABBREVIATIONS


- | | |
|-----|--|
| AMP | AMPERE |
| AC | ALTERNATING CURRENT |
| AL | ALUMINUM |
| AF | AMP. FRAME |
| AFF | ABOVE FINISHED FLOOR |
| AFG | ABOVE FINISHED GRADE |
| AWG | AMERICAN WIRE GAUGE |
| C | CONDUIT (GENERIC TERM OF RACEWAY, PROVIDE AS SPECIFIED) |
| CB | COMBINER BOX |
| CKT | CIRCUIT |
| CT | CURRENT TRANSFORMER |
| CU | COPPER |
| DC | DIRECT CURRENT |

ABBREVIATIONS CONTINUED

- | | |
|--------|--|
| DISC | DISCONNECT SWITCH |
| DWG | DRAWING |
| EC | ELECTRICAL SYSTEM INSTALLER |
| EMT | ELECTRICAL METALLIC TUBING |
| FS | FUSIBLE SWITCH |
| FU | FUSE |
| GND | GROUND |
| GFI | GROUND FAULT INTERRUPTER |
| HZ | FREQUENCY (CYCLES PER SECOND) |
| JB | JUNCTION BOX |
| kCMIL | THOUSAND CIRCULAR MILS |
| KVA | KILO-VOLT AMPERE |
| KW | KILO-WATT |
| KWH | KILO-WATT HOUR |
| L | LINE |
| MCB | MAIN CIRCUIT BREAKER |
| MDP | MAIN DISTRIBUTION PANEL |
| MLO | MAIN LUG ONLY |
| MTD | MOUNTED |
| MTG | MOUNTING |
| N | NEUTRAL |
| NEC | NATIONAL ELECTRICAL CODE |
| NIC | NOT IN CONTRACT |
| NO # | NUMBER |
| NTS | NOT TO SCALE |
| OCP | OVER CURRENT PROTECTION |
| P | POLE |
| PB | PULL BOX |
| PH Ø | PHASE |
| PVC | POLY-VINYL CHLORIDE CONDUIT |
| PWR | POWER |
| QTY | QUANTITY |
| RGS | RIGID GALVANIZED STEEL |
| SN | SOLID NEUTRAL |
| JSWBD | SWITCHBOARD |
| TYP | TYPICAL |
| U.O.I. | UNLESS OTHERWISE INDICATED |
| WP | WEATHERPROOF |
| XFMR | TRANSFORMER |
| +72 | MOUNT 72 INCHES TO BOTTOM OF ABOVE FINISHED FLOOR OR GRADE |

SHEET INDEX


- | | |
|------|----------------------------------|
| PV-1 | COVER SHEET W/ SITE INFO & NOTES |
| PV-2 | ROOF PLAN W/ MODULE LOCATIONS |
| PV-3 | RACKING DETAILS |
| PV-4 | ELECTRICAL 3 LINE DIAGRAM |
| AP | APPENDIX |

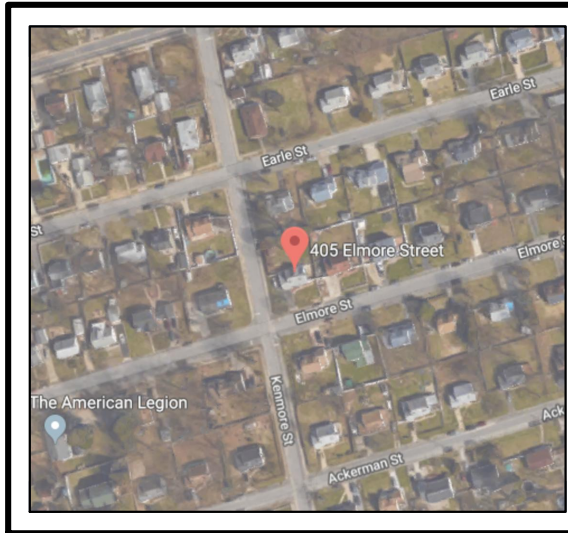

VICINITY MAP
SCALE: NTS



SATELLITE VIEW
SCALE: NTS

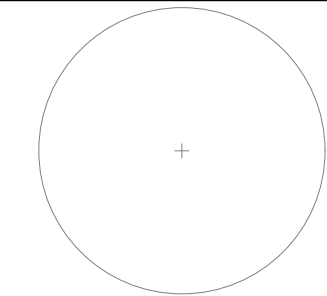

Issued / Revisions		
A1	AS BUILT	9/5/2018
P1	ISSUED TO TOWNSHIP FOR PERMIT	6/18/2018
NO.	DESCRIPTION	DATE

Project Title:

MARQUEZ, JUAN

TRINITY ACCT #: 2018-04-255124

Project Address:

405 ELMORE ST
CENTRAL ISLIP, NY 11722
40.785035,-73.197911

Drawing Title:

AS BUILT PV SOLAR SYSTEM



Drawing Information	
DRAWING DATE:	6/18/2018
DRAWN BY:	IG
REVISED BY:	JMS

System Information:	
DC SYSTEM SIZE:	4.13kW
AC SYSTEM SIZE:	3.8kW
TOTAL MODULE COUNT:	14
MODULES USED:	HANWHA 295
MODULE SPEC #:	Q.PEAK-BLK G4.1 295
UTILITY COMPANY:	PSEG-LI
UTILITY ACCT #:	8132725501
UTILITY METER #:	98814856
DEAL TYPE:	SUNNOVA

Rev. No.	Sheet
A1	PV - 1



SIZE OF EXISTING RAFTER: 2" x 6"
RAFTER SPACING: 16" o.c.
ROOF PITCH R1: 43 ° (ASPHALT SHINGLE)
ADDITIONAL SUPPORT PROVIDED: N/A
THE EXISTING ROOF RAFTERS AT THIS
RESIDENCE CAN ADEQUATELY SUPPORT
THE PROPOSED SOLAR PV PANEL
ASSEMBLY (4.3 LBS. PSF) AND THE
SNOW LOADS (16 LBS. PSF) . IN
ADDITION, THE 3" STAINLESS STEEL
LAG SCREWS INSTALLED AT 4' o.c. MEET
THE UPLIFT REQUIREMENTS OF 4 SCREW
MINIMUM PER ASSEMBLY, 6 SCREWS ARE
PROVIDED. THIS INSTALLATION MEETS
THE REQUIREMENTS OF THE RESIDENTIAL
CODE OF NEW YORK STATE AND HAS
BEEN FOUND TO BE ACCEPTABLE BY MY
OFFICE.

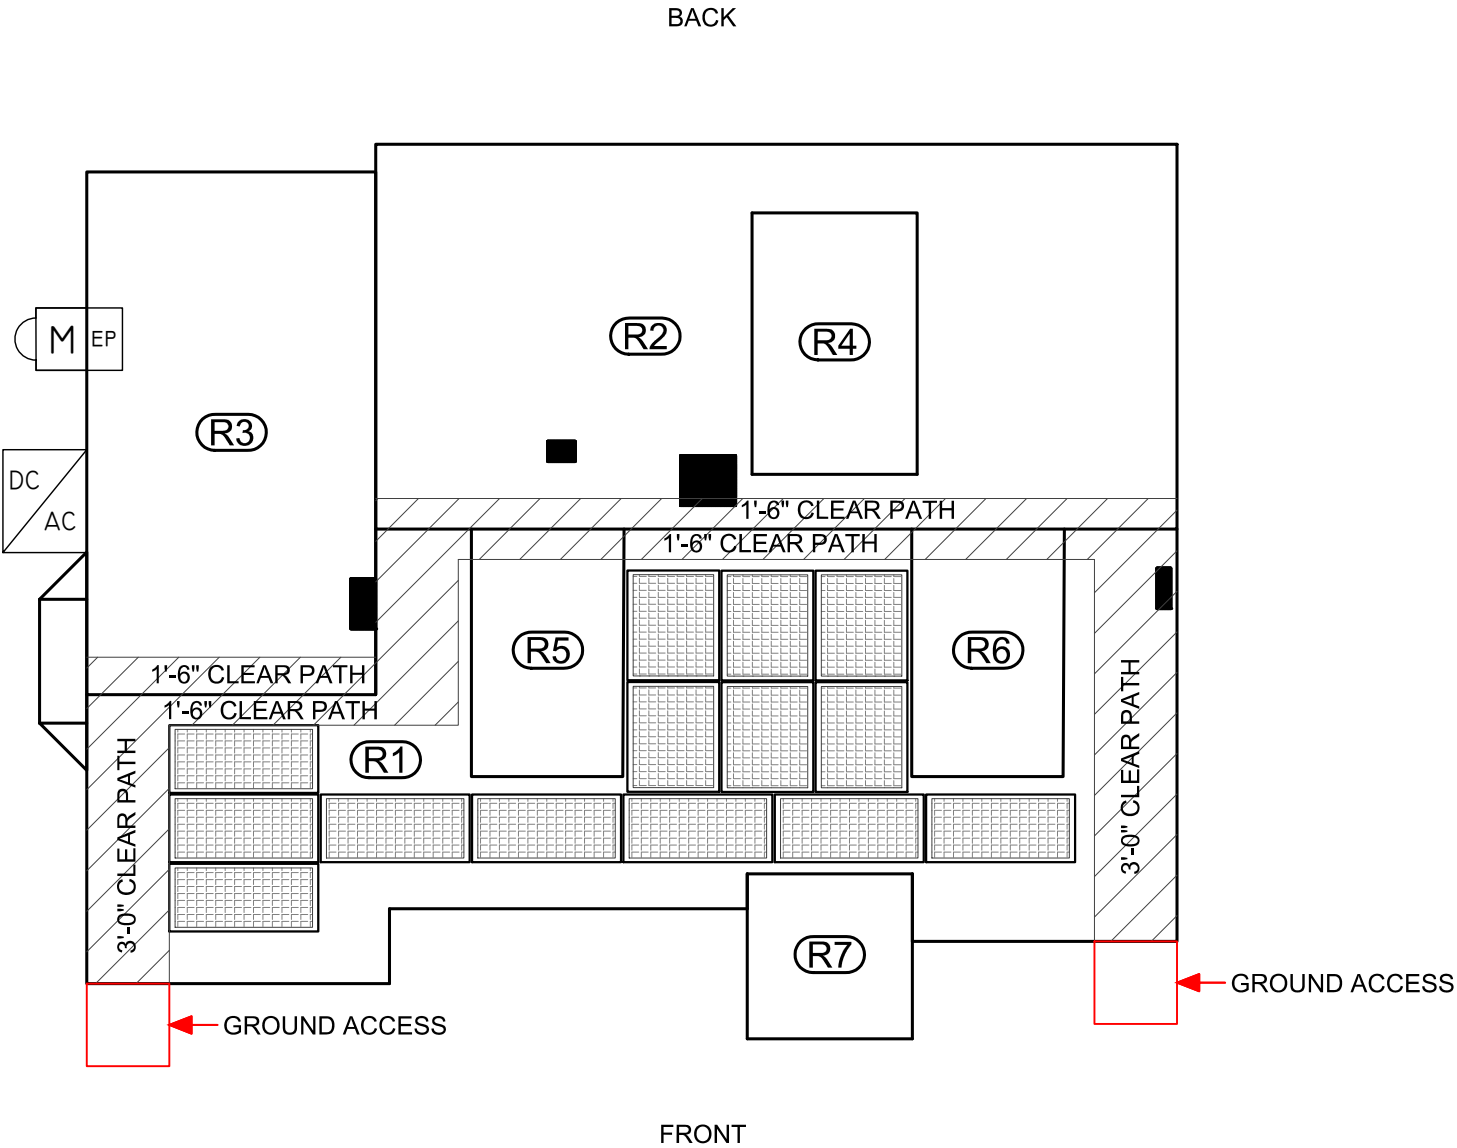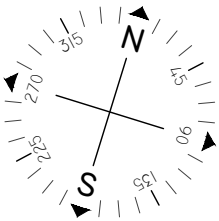

ROOF 1
MODULES: 14
PITCH: 43°
ORIENTATION: 163°

ROOF 2
MODULES: 0
PITCH: 43°
ORIENTATION: 343°

ROOF 3
MODULES: 0
PITCH: 25°
ORIENTATION: 343°

ROOF 4
MODULES: 0
PITCH: 9°
ORIENTATION: 343°

ROOF 5
MODULES: 0
PITCH: 30°
ORIENTATION: 163°

ROOF 6
MODULES: 0
PITCH: 30°
ORIENTATION: 163°

ROOF 7
MODULES: 0
PITCH: 14°
ORIENTATION: 163°

- NOTES:
- 1.) ALL EQUIPMENT SHALL BE INSTALLED IN ACCORDANCE WITH THE MANUFACTURER'S INSTALLATION INSTRUCTIONS.
 - 2.) ARRAY BONDING TO COMPLY WITH MANUFACTURER SPECIFICATION.
 - 3.) ALL LOCATIONS ARE APPROXIMATE AND REQUIRE FIELD VERIFICATION.
 - 4.) AN AC DISCONNECT SHALL BE GROUPED WITH INVERTER (S) NEC 690.13 (E) .
 - 5.) ALL OUTDOOR EQUIPMENT SHALL BE RAIN TIGHT WITH MINIMUM NEMA 3R RATING.
 - 6.) ROOFTOP SOLAR INSTALLATION ONLY PV ARRAY SHALL NOT EXTEND BEYOND THE EXISTING ROOF EDGE.

SYMBOL LEGEND

	INDICATES ROOF DESIGNATION . REFER TO ARRAY SCHEDULE FOR MORE INFORMATION		INDICATES NEW UTILITY DISCONNECT TO BE INSTALLED OUTSIDE		INDICATES NEW PV ONLY SUBPANEL TO BE INSTALLED
	INDICATES EXISTING METER LOCATION		INDICATES NEW PV SOLAR MODULE. RED MODULES INDICATE PANELS THAT USE MICRO INVERTERS. REFER TO EQUIPMENT SCHEDULE FOR SPECS.		
	INDICATES EXISTING ELECTRICAL PANEL LOCATION: INSIDE		INDICATES NEW PRODUCTION METER TO BE INSTALLED OUTSIDE.		
	INDICATES NEW FUSED PV DISCONNECT TO BE INSTALLED OUTSIDE		INDICATES NEW INVERTER TO BE INSTALLED OUTSIDE. REFER TO EQUIPMENT SCHEDULE FOR SPECS.		

PLUMBING SCHEDULE

OTHER OBSTRUCTIONS

EQUIPMENT SCHEDULE

QTY	SPEC #
14	HANWHA 295 (Q.PEAK-BLK G4.1 295)
1	SE3800H-US000NNC2

Issued / Revisions		
A1	AS BUILT	9/5/2018
P1	ISSUED TO TOWNSHIP FOR PERMIT	6/18/2018
NO.	DESCRIPTION	DATE

Project Title:

MARQUEZ, JUAN

TRINITY ACCT #: 2018-04-255124

Project Address:

405 ELMORE ST
CENTRAL ISLIP, NY 11722
40.785035,-73.197911


Drawing Title:

AS BUILT PV SOLAR SYSTEM


Drawing Information	
DRAWING DATE:	6/18/2018
DRAWN BY:	IG
REVISED BY:	JMS

System Information:	
DC SYSTEM SIZE:	4.13kW
AC SYSTEM SIZE:	3.8kW
TOTAL MODULE COUNT:	14
MODULES USED:	HANWHA 295
MODULE SPEC #:	Q.PEAK-BLK G4.1 295
UTILITY COMPANY:	PSEG-LI
UTILITY ACCT #:	8132725501
UTILITY METER #:	98814856
DEAL TYPE:	SUNNOVA


Rev. No.	Sheet
A1	PV - 2

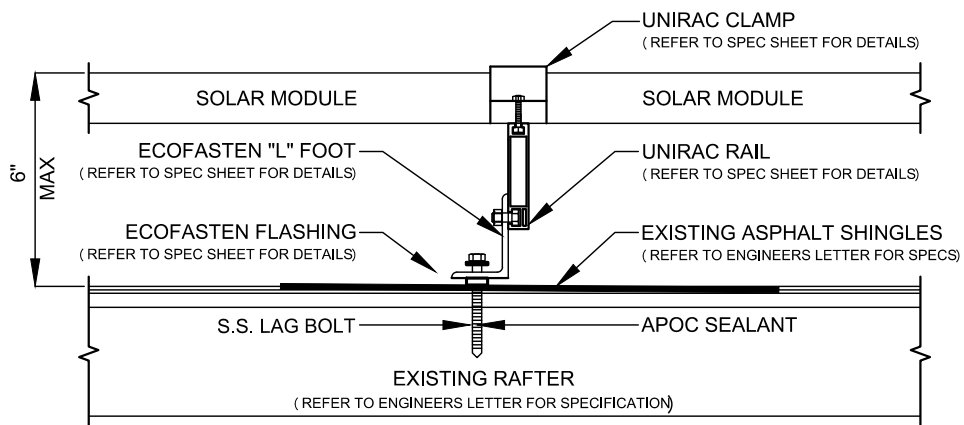

 PV MODULE ATTACHMENT ON ASPHALT SHINGLE ROOF
SCALE: NOT TO SCALE

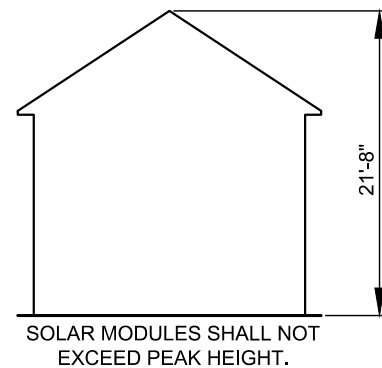

 HEIGHT FROM GROUND LEVEL TO PEAK OF ROOF
SCALE: NOT TO SCALE

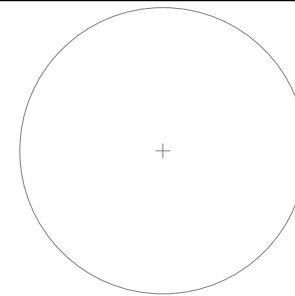

Issued / Revisions

NO.	DESCRIPTION	DATE
A1	AS BUILT	9/5/2018
P1	ISSUED TO TOWNSHIP FOR PERMIT	6/18/2018

Project Title:

MARQUEZ, JUAN
TRINITY ACCT #: 2018-04-255124

Project Address:

405 ELMORE ST
CENTRAL ISLIP, NY 11722
40.785035,-73.197911

Drawing Title:

AS BUILT PV SOLAR SYSTEM

Drawing Information

DRAWING DATE:	6/18/2018
DRAWN BY:	IG
REVISED BY:	JMS

System Information:

DC SYSTEM SIZE:	4.13kW
AC SYSTEM SIZE:	3.8kW
TOTAL MODULE COUNT:	14
MODULES USED:	HANWHA 295
MODULE SPEC #:	Q.PEAK-BLK G4.1 295
UTILITY COMPANY:	PSEG-LI
UTILITY ACCT #:	8132725501
UTILITY METER #:	98814856
DEAL TYPE:	SUNNOVA

Rev. No.

A1

Sheet

PV - 3



ARRAY CIRCUIT WIRING NOTES

1.) LICENSED ELECTRICIAN ASSUMES ALL RESPONSIBILITY FOR DETERMINING ONSITE CONDITIONS AND EXECUTING INSTALLATION IN ACCORDANCE WITH NEC 2014

2.) LOWEST EXPECTED AMBIENT TEMPERATURE BASED ON ASHRAE MINIMUM MEAN EXTREME DRY BULB TEMPERATURE FOR ASHRAE LOCATION MOST SIMILAR TO INSTALLATION LOCATION. LOWEST EXPECTED AMBIENT TEMP = -16°C

3.) HIGHEST CONTINUOUS AMBIENT TEMPERATURE BASED ON ASHRAE HIGHEST MONTH 2% DRY BULB TEMPERATURE FOR ASHRAE LOCATION MOST SIMILAR TO INSTALLATION LOCATION. HIGHEST CONTINUOUS TEMP = 33°C

4.) 2005 ASHRAE FUNDAMENTALS 2% DESIGN TEMPERATURES DO NOT EXCEED 47°C IN THE UNITED STATES (PALM SPRINGS, CA IS 44.1°C). FOR LESS THAN 9 CURRENT-CARRYING CONDUCTORS IN A ROOF-MOUNTED SUNLIT CONDUIT AT LEAST 0.5" ABOVE ROOF AND USING THE OUTDOOR DESIGN TEMPERATURE OF 47°C OR LESS (ALL OF UNITED STATES)

5.) PV SYSTEM CIRCUITS INSTALLED ON OR IN BUILDINGS SHALL INCLUDE A RAPID SHUTDOWN FUNCTION THAT CONTROLS SPECIFIC CONDUCTORS IN ACCORDANCE WITH NEC 690.12(1) THROUGH (5)

6.) PHOTOVOLTAIC POWER SYSTEMS SHALL BE PERMITTED TO OPERATE WITH UNGROUNDED PHOTOVOLTAIC SOURCE AND OUTPUT CIRCUIT AS PER NEC 690.35

7.) UNGROUNDED DC CIRCUIT CONDUCTORS SHALL BE IDENTIFIED WITH THE FOLLOWING OUTER FINISH:
POSITIVE CONDUCTORS = RED
NEGATIVE CONDUCTORS = BLACK
NEC 210.5(C)(2)

8.) ARRAY AND SUB ARRAY CONDUCTORS SHALL BE #10 PV WIRE TYPE RHW-2 OR EQUIVELANT AND SHALL BE PROTECTED BY CONDUIT WHERE EXPOSED TO DIRECT SUNLIGHT. SUB ARRAY CONDUIT LONGER THAN 24" SHALL CONTAIN ≤ 20 CURRENT CARRYING CONDUCTORS AND WHERE EXPOSED TO DIRECT SUNLIGHT SHALL CONTAIN ≤ 9 CURRENT CARRYING CONDUCTORS.

9.) ALL WIRE LENGTHS SHALL BE LESS THAN 100' UNLESS OTHERWISE NOTED

10.) FLEXIBLE CONDUIT SHALL NOT BE INSTALLED ON ROOFTOP AND SHALL BE LIMITED TO 12" IF USED OUTDOORS

11.) OVERCURRENT PROTECTION FOR CONDUCTORS CONNECTED TO THE SUPPLY SIDE OF A SERVICE SHALL BE LOCATED WITHIN 10' OF THE POINT OF CONNECTION NEC 705.31

12.) WHERE TWO SOURCES FEED A BUSSBAR, ONE A UTILITY AND THE OTHER AN INVERTER, PV BACKFEED BREAKER(S) SHALL BE LOCATED OPPOSITE FROM UTILITY NEC 705.12(D)(2)(3)(b)

13.) ALL SOLAR SYSTEM LOAD CENTERS TO CONTAIN ONLY GENERATION CIRCUITS AND NO UNUSED POSITIONS OR LOADS

14.) ALL EQUIPMENT INSTALLED OUTDOORS SHALL HAVE A NEMA 3R RATING

CALCULATIONS FOR CURRENT CARRYING CONDUCTORS
REQUIRED CONDUCTOR AMPACITY PER STRING
[NEC 690.8(B)(1)]: (15.00*1.25)1 = 18.75A

AWG #10, DERATED AMPACITY
AMBIENT TEMP: 33°C, TEMP DERATING FACTOR: .96
RACEWAY DERATING = 2 CCC: 1.00
(40*.96)1.00 = 38.40A


38.40A ≥ 18.75A, THEREFORE WIRE SIZE IS VALID

TOTAL AC REQUIRED CONDUCTOR AMPACITY
16.00A*1.25 = 20.00A

AWG #10, DERATED AMPACITY
AMBIENT TEMP: 30°C, TEMP DERATING: 1.0
RACEWAY DERATING ≤ 3 CCC: N/A
40A*1.0 = 40A

40A ≥ 20.00A, THEREFORE AC WIRE SIZE IS VALID

CALCULATION FOR PV OVERCURRENT PROTECTION
TOTAL INVERTER CURRENT: 16.00A
16.00A*1.25 = 20.00A
--> 20A OVERCURRENT PROTECTION IS VALID

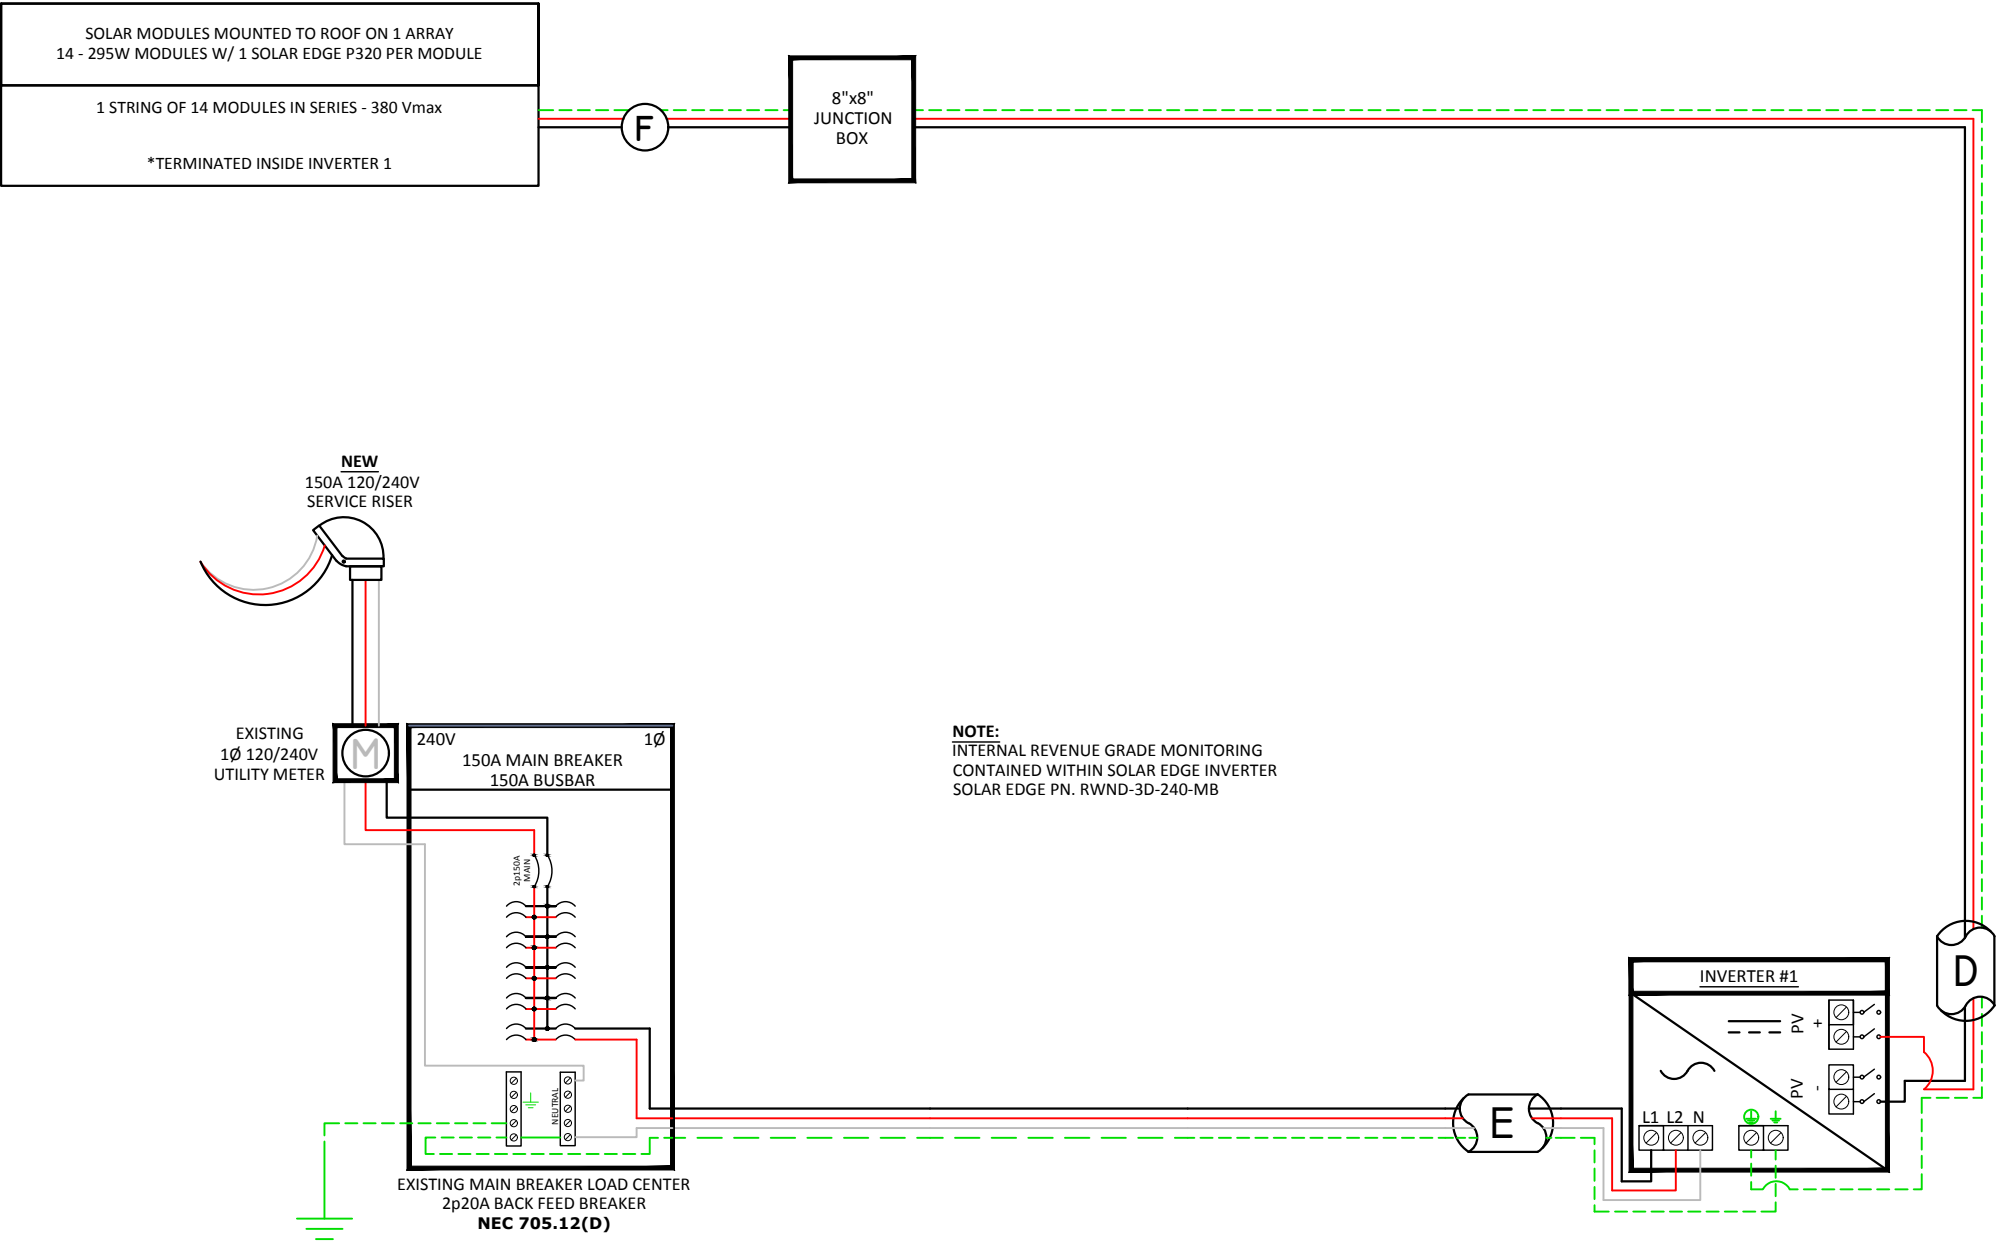

NOTE:
INTERNAL REVENUE GRADE MONITORING
CONTAINED WITHIN SOLAR EDGE INVERTER
SOLAR EDGE PN. RWND-3D-240-MB

NOTE: CONDUIT TYPE SHALL BE CHOSEN BY THE INSTALLATION CONTRACTOR TO MEET OR EXCEED NEC AND LOCAL AHJD REQUIREMENTS

A	#6 THWN-2 GEC TO EXISTING GROUND ROD
B	1" CONDUIT W/ 3-#10 THWN-2, 1-#10 THWN-2 GROUND
C	1" CONDUIT W/ 2-#10 THWN-2, 1-#10 THWN-2 GROUND
D	1" CONDUIT W/ 2-#10 THWN-2, 1-#10 THWN-2 GROUND
E	1" CONDUIT W/ 2-#10 THWN-2, 1-#10 THWN-2, 1-#10 THWN-2 GROUND
F	#10 PV WIRE (FREE AIR) W/ #6 BARE COPPER BOND TO ARRAY

PV MODULE SPECIFICATIONS	
HANWHA 295 (Q.PEAK-BLK G4.1 295)	
Imp	9.17
Vmp	32.19
Voc	39.48
Isc	9.7

INVERTER #1 - SE3800H-US000NNC2			
DC		AC	
Imp	10.5	Pout	3800
Vmp	380	Imax	16
Voc	480	OCpDmin	20
Isc	15	Vnom	240

Issued / Revisions

A1	AS BUILT	9/5/2018
P1	ISSUED TO TOWNSHIP FOR PERMIT	6/18/2018
NO.	DESCRIPTION	DATE

Project Title:
MARQUEZ, JUAN
TRINITY ACCT #: 2018-04-255124

Project Address:
**405 ELMORE ST
CENTRAL ISLIP, NY 11722
40.785035,-73.197911**

Drawing Title:
AS BUILT PV SOLAR SYSTEM

Drawing Information	
DRAWING DATE:	6/18/2018
DRAWN BY:	IG
REVISED BY:	JMS

System Information:	
DC SYSTEM SIZE:	4.13kW
AC SYSTEM SIZE:	3.8kW
TOTAL MODULE COUNT:	14
MODULES USED:	HANWHA 295
MODULE SPEC #:	Q.PEAK-BLK G4.1 295
UTILITY COMPANY:	PSEG-LI
UTILITY ACCT #:	8132725501
UTILITY METER #:	98814856
DEAL TYPE:	SUNNOVA

Rev. No.	Sheet
A1	PV - 4



2211 Allenwood Road
Wall, New Jersey 07719
877-786-7283
www.Trinity-Solar.com