


# REINSTALLATION OF EXISTING ROOF MOUNTED PV SOLAR SYSTEM

## 3 AUTUMN LANE BURLINGTON TWP, NJ 08016

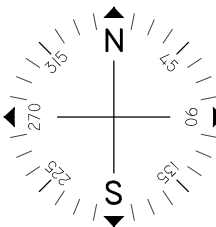

### Issued / Revisions

NO.	DESCRIPTION	DATE
P1	ISSUED TO TOWNSHIP FOR PERMIT	12/4/2017

Project Title:
COCHRAN, STEPHANIE TRINITY ACCT #: 2011-03-2561

Project Address:
3 AUTUMN LANE BURLINGTON TWP, NJ 08016 40.055509, -74.874369

Drawing Title:
PROPOSED REINSTALLATION OF EXISTING PV SOLAR SYSTEM

Drawing Information	
DRAWING DATE:	12/4/2017
DRAWN BY:	JC
REVISED BY:	

System Information:	
DC SYSTEM SIZE:	7.755kW
AC SYSTEM SIZE:	7kW
TOTAL MODULE COUNT:	33
MODULES USED:	TRINA 235
MODULE SPEC #:	TSM-235 PC/PA05.08
UTILITY COMPANY:	PSE&G
UTILITY ACCT #:	6572682404
UTILITY METER #:	2684335
DEAL TYPE:	SUNRUN

Rev. No.	Sheet
P1	PV - 1



2211 Allenwood Road  
Wall, New Jersey 07719

877-797-2978  
www.Trinity-Solar.com

### GENERAL NOTES

1. THE INSTALLATION CONTRACTOR IS RESPONSIBLE FOR INSTALLING ALL EQUIPMENT AND FOLLOWING ALL DIRECTIONS AND INSTRUCTIONS CONTAINED IN THE DRAWING PACKAGE AND INFORMATION RECEIVED FROM TRINITY.
2. THE INSTALLATION CONTRACTOR IS RESPONSIBLE FOR INSTALLING ALL EQUIPMENT AND FOLLOWING ALL DIRECTIONS AND INSTRUCTION CONTAINED IN THE COMPLETE MANUAL.
3. THE INSTALLATION CONTRACTOR IS RESPONSIBLE FOR READING AND UNDERSTANDING ALL DRAWINGS, COMPONENT AND INVERTER MANUALS PRIOR TO INSTALLATION. THE INSTALLATION CONTRACTOR IS ALSO REQUIRED TO HAVE ALL COMPONENT SWITCHES IN THE OFF POSITION AND FUSES REMOVED PRIOR TO THE INSTALLATION OF ALL FUSE BEARING SYSTEM COMPONENTS.
4. ONCE THE PHOTOVOLTAIC MODULES ARE MOUNTED, THE INSTALLATION CONTRACTOR SHOULD HAVE A MINIMUM OF ONE ELECTRICIAN WHO HAS ATTENDED A SOLAR PHOTOVOLTAIC INSTALLATION COURSE ON SITE.
5. FOR SAFETY, IT IS RECOMMENDED THAT THE INSTALLATION CREW ALWAYS HAVE A MINIMUM OF TWO PERSONS WORKING TOGETHER AND THAT EACH OF THE INSTALLATION CREW MEMBERS BE TRAINED IN FIRST AID AND CPR.
6. THIS SOLAR PHOTOVOLTAIC SYSTEM IS TO BE INSTALLED FOLLOWING THE CONVENTIONS OF THE NATIONAL ELECTRICAL CODE. ANY LOCAL CODE WHICH MAY SUPERSEDE THE NEC SHALL GOVERN.
7. ALL SYSTEM COMPONENTS TO BE INSTALLED WITH THIS SYSTEM ARE TO BE "UL" LISTED. ALL EQUIPMENT WILL BE NEMA 3R OUTDOOR RATED UNLESS INDOORS.

### GENERAL NOTES

IF ISSUED DRAWING IS MARKED WITH A REVISION CHARACTER OTHER THAN "A", PLEASE BE ADVISED THAT FINAL EQUIPMENT AND/OR SYSTEM CHARACTERISTICS ARE SUBJECT TO CHANGE DUE TO AVAILABILITY OF EQUIPMENT.

### GENERAL NOTES CONTINUED

8. THE DC VOLTAGE FROM THE PANELS IS ALWAYS PRESENT AT THE DC DISCONNECT ENCLOSURE AND THE DC TERMINALS OF THE INVERTER DURING DAYLIGHT HOURS. ALL PERSONS WORKING ON OR INVOLVED WITH THE PHOTOVOLTAIC SYSTEM ARE WARNED THAT THE SOLAR MODULES ARE ENERGIZED WHENEVER THEY ARE EXPOSED TO LIGHT.
9. ALL PORTIONS OF THIS SOLAR PHOTOVOLTAIC SYSTEM SHALL BE MARKED CLEARLY IN ACCORDANCE WITH THE NATIONAL ELECTRICAL CODE ARTICLE 690 & 705.
10. PRIOR TO THE INSTALLATION OF THIS PHOTOVOLTAIC SYSTEM, THE INSTALLATION CONTRACTOR SHALL ATTEND A PRE-INSTALLTION MEETING FOR THE REVIEW OF THE INSTALLATION PROCEDURES, SCHEDULES, SAFETY AND COORDINATION.
11. PRIOR TO THE SYSTEM START UP THE INSTALLATION CONTRACTOR SHALL ASSIST IN PERFORMING ALL INITIAL HARDWARE CHECKS AND DC WIRING CONDUCTIVITY CHECKS.
12. FOR THE PROPER MAINTENANCE AND ISOLATION OF THE INVERTERS REFER TO THE ISOLATION PROCEDURES IN THE OPERATION MANUAL.
13. THE LOCATION OF PROPOSED ELECTRIC AND TELEPHONE UTILITIES ARE SUBJECT TO FINAL APPROVAL OF THE APPROPRIATE UTILITY COMPANIES AND OWNERS.
14. ALL MATERIALS, WORKMANSHIP AND CONSTRUCTION FOR THE SITE IMPROVEMENTS SHOWN HEREIN SHALL BE IN ACCORDANCE WITH:
  - A) CURRENT PREVAILING MUNICIPAL AND/OR COUNTY SPECIFICATIONS, STANDARDS AND REQUIREMENTS

### GENERAL NOTES CONTINUED

14. B) CURRENT PREVAILING UTILITY COMPANY SPECIFICATIONS, STANDARDS, AND REQUIREMENTS
15. THIS SET OF PLANS HAVE BEEN PREPARED FOR THE PURPOSE OF MUNICIPAL AND AGENCY REVIEW AND APPROVAL. THIS SET OF PLANS SHALL NOT BE UTILIZED AS CONSTRUCTION DRAWINGS UNTIL REVISED TO INDICATE "ISSUED FOR CONSTRUCTION".
16. ALL INFORMATION SHOWN MUST BE CERTIFIED PRIOR TO USE FOR CONSTRUCTION ACTIVITIES.

### ABBREVIATIONS

AMP	AMPERE
AC	ALTERNATING CURRENT
AL	ALUMINUM
AF	AMP. FRAME
AFF	ABOVE FINISHED FLOOR
AFG	ABOVE FINISHED GRADE
AWG	AMERICAN WIRE GAUGE
C	CONDUIT ( GENERIC TERM OF SPECIFIED)
CB	COMBINER BOX
CKT	CIRCUIT
CT	CURRENT TRANSFORMER
CU	COPPER
DC	DIRECT CURRENT
DISC	DISCONNECT SWITCH
DWG	DRAWING
EC	ELECTRICAL SYSTEM INSTALLER
EMT	ELECTRICAL METALLIC TUBING
FS	FUSIBLE SWITCH
FU	FUSE
GND	GROUND
GFI	GROUND FAULT INTERRUPTER
HZ	FREQUENCY ( CYCLES PER SECOND)


### ABBREVIATIONS CONTINUED

JB	JUNCTION BOX
KCMIL	THOUSAND CIRCULAR MILS
KVA	KILO-VOLT AMPERE
KW	KILO-WATT
KWH	KILO-WATT HOUR
L	LINE
MCB	MAIN CIRCUIT BREAKER
MDP	MAIN DISTRIBUTION PANEL
MLO	MAIN LUG ONLY
MTD	MOUNTED
MTG	MOUNTING
N	NEUTRAL
NEC	NATIONAL ELECTRICAL CODE
NIC	NOT IN CONTRACT
NO #	NUMBER
NTS	NOT TO SCALE
OCP	OVER CURRENT PROTECTION
P	POLE
PB	PULL BOX
PH ∅	PHASE
PVC	POLY-VINYL CHLORIDE CONDUIT
PWR	POWER
QTY	QUANTITY
RGS	RIGID GALVANIZED STEEL
SN	SOLID NEUTRAL
JSWBD	SWITCHBOARD
TYP	TYPICAL
U.O.I.	UNLESS OTHERWISE INDICATED
WP	WEATHERPROOF
XFMR	TRANSFORMER
+72	MOUNT 72 INCHES TO BOTTOM OF ABOVE FINISHED FLOOR OR GRADE


### SHEET INDEX

PV-1	COVER SHEET W/ SITE INFO & NOTES
PV-2	ROOF PLAN W/ MODULE LOCATIONS
PV-3	ELECTRICAL 3 LINE DIAGRAM
AP	APPENDIX


NOTES : \*REFER TO MODULE SPECS FOR MODULE DIMENSIONS  
\*DEPICTED MODULES MAY BE PORTRAIT OR LANDSCAPE

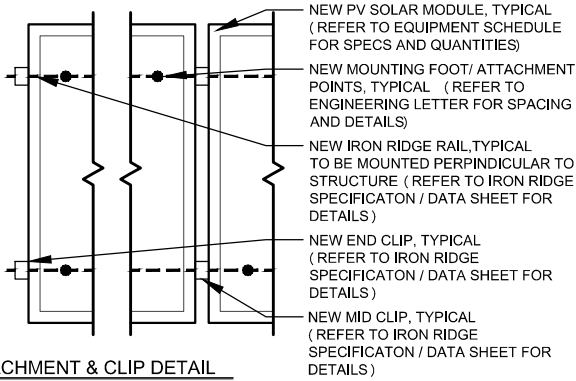

ATTACHMENT & CLIP DETAIL  
SCALE: NOT TO SCALE

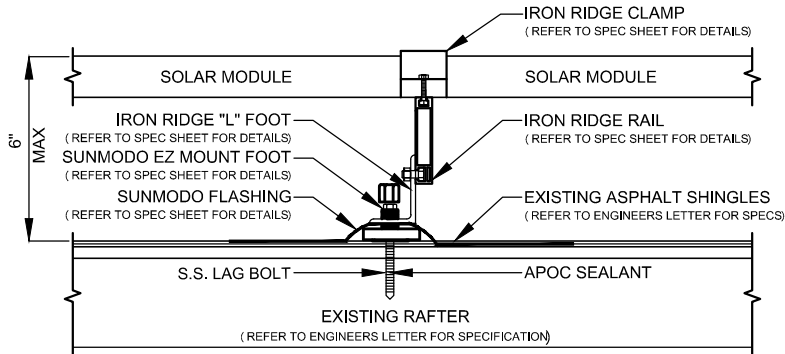


PV MODULE ATTACHMENT ON ASPHALT SHINGLE ROOF  
SCALE: NOT TO SCALE

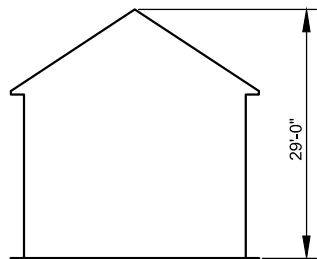

HEIGHT FROM GROUND LEVEL TO PEAK OF ROOF  
SCALE: NOT TO SCALE


## EXSITING PV SYSTEM REINSTALLATION OF MODULES ONLY

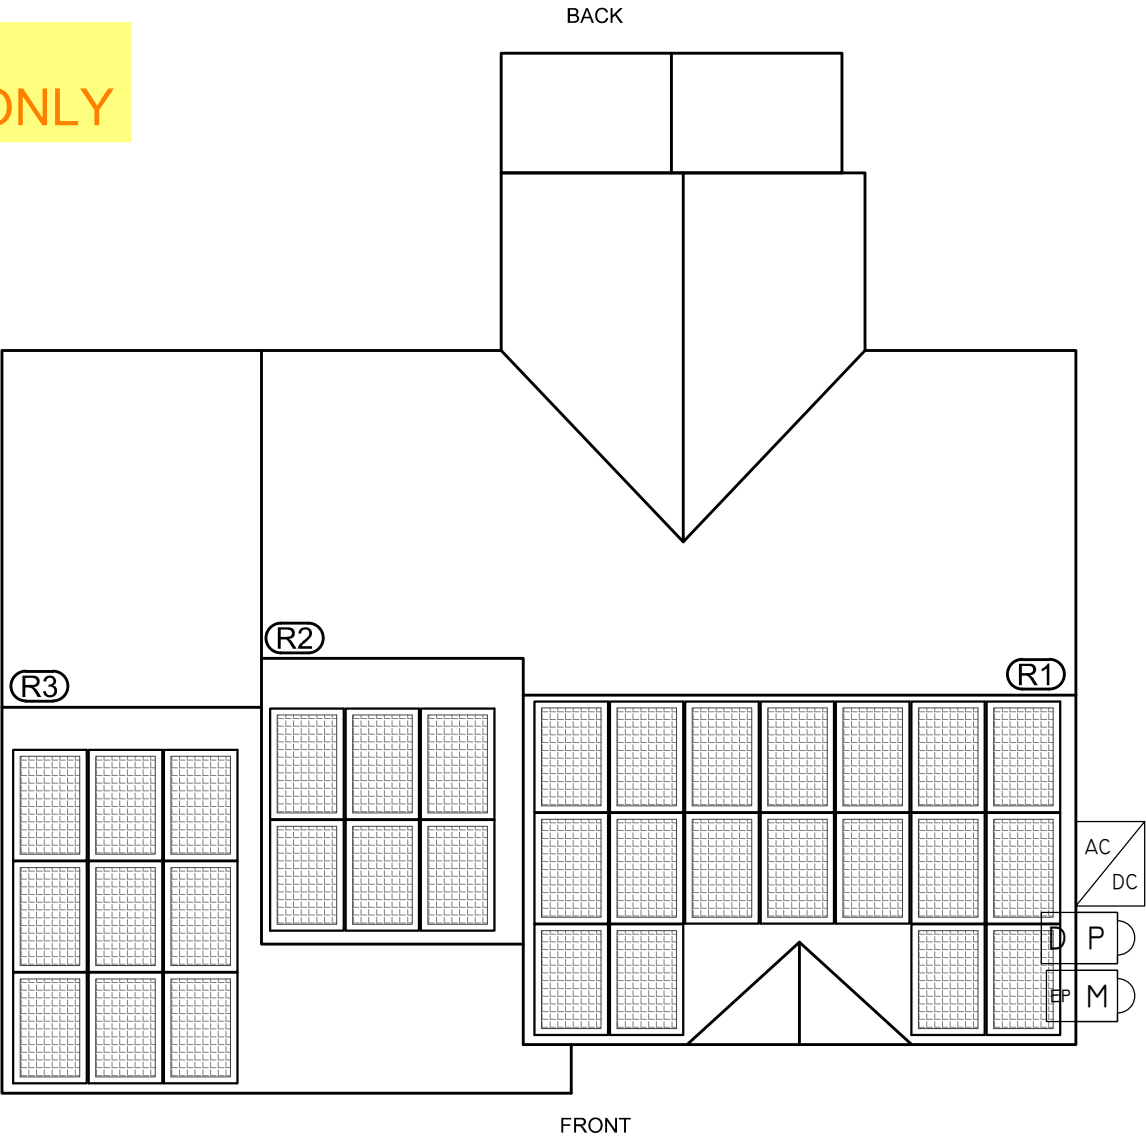

NOTES:

- 1.) ALL EQUIPMENT SHALL BE INSTALLED IN ACCORDANCE WITH THE MANUFACTURER'S INSTALLATION INSTRUCTIONS.
- 2.) ARRAY BONDING TO COMPLY WITH MANUFACTURER SPECIFICATION.
- 3.) ALL LOCATIONS ARE APPROXIMATE AND REQUIRE FIELD VERIFICATION.
- 4.) AN AC DISCONNECT SHALL BE GROUPED WITH INVERTER ( S ) NEC 690.13 ( E ) .
- 5.) ALL OUTDOOR EQUIPMENT SHALL BE RAIN TIGHT WITH MINIMUM NEMA 3R RATING.
- 6.) ROOFTOP SOLAR INSTALLATION ONLY PV ARRAY SHALL NOT EXTEND BEYOND THE EXISTING ROOF EDGE.

ARRAY SCHEDULE		SYMBOL LEGEND			PLUMBING SCHEDULE	EQUIPMENT SCHEDULE	
R1	ARRAY ORIENTATION = 91° MODULE PITCH = 25°	(R1)	INDICATES ROOF DESIGNATION . REFER TO ARRAY SCHEDULE FOR MORE INFORMATION	UD	INDICATES NEW UTILITY DISCONNECT TO BE INSTALLED OUTSIDE	QTY	SPEC #
R2	ARRAY ORIENTATION = 91° MODULE PITCH = 25°	M	INDICATES EXISTING METER LOCATION		INDICATES NEW PV SOLAR MODULE. RED MODULES INDICATE PANELS THAT USE MICRO INVERTERS. REFER TO EQUIPMENT SCHEDULE FOR SPECS.	33	TRINA 235 (TSM-235 PC/PA05.08)
R3	ARRAY ORIENTATION = 91° MODULE PITCH = 25°	EP	INDICATES EXISTING ELECTRICAL PANEL LOCATION: INSIDE	P	INDICATES NEW PRODUCTION METER TO BE INSTALLED OUTSIDE.	1	SMA SB 7000-US
		D	INDICATES NEW MAIN DISCONNECT	DC AC	INDICATES NEW INVERTER TO BE INSTALLED OUTSIDE. REFER TO EQUIPMENT SCHEDULE FOR SPECS.		
						OTHER OBSTRUCTIONS	

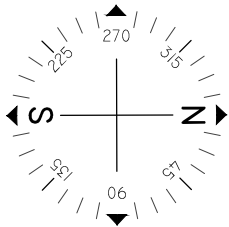

Issued / Revisions

NO.	DESCRIPTION	DATE
P1	ISSUED TO TOWNSHIP FOR PERMIT	12/4/2017

Project Title:

COCHRAN, STEPHANIE  
TRINITY ACCT #: 2011-03-2561

Project Address:

3 AUTUMN LANE  
BURLINGTON TWP, NJ 08016  
40.055509, -74.874369

Drawing Title:

PROPOSED REINSTALLATION OF  
EXISTING PV SOLAR SYSTEM

Drawing Information

DRAWING DATE:	12/4/2017
DRAWN BY:	JC
REVISED BY:	

System Information:

DC SYSTEM SIZE:	7.755kW
AC SYSTEM SIZE:	7kW
TOTAL MODULE COUNT:	33
MODULES USED:	TRINA 235
MODULE SPEC #:	TSM-235 PC/PA05.08
UTILITY COMPANY:	PSE&G
UTILITY ACCT #:	6572682404
UTILITY METER #:	2684335
DEAL TYPE:	SUNRUN

Rev. No.

P1


Sheet

PV - 2



2211 Allenwood Road  
Wall, New Jersey 07719

877-797-2978  
www.Trinity-Solar.com

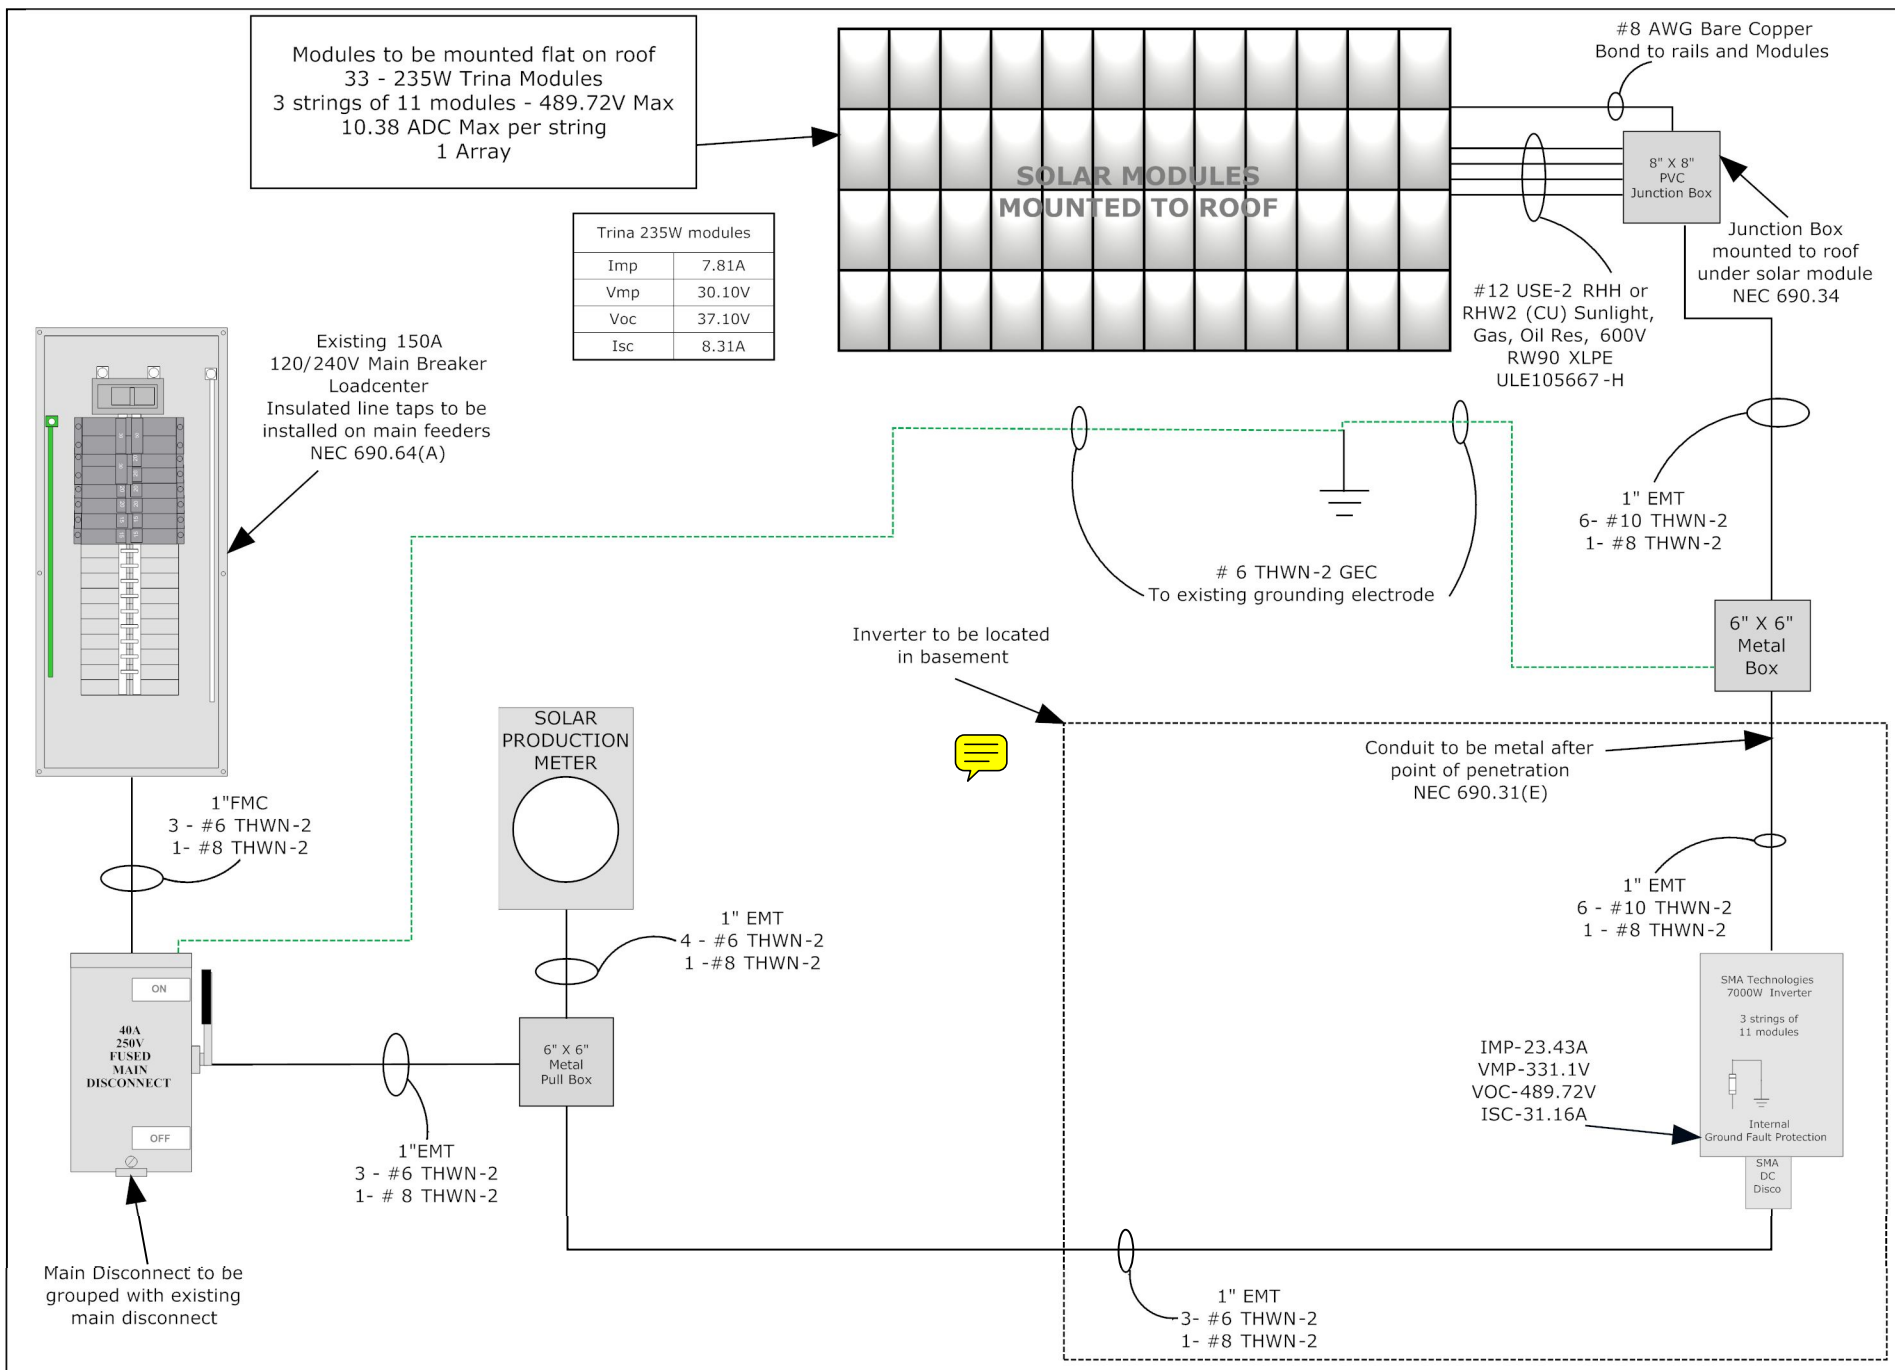

800 US Highway 9 South  
Freehold, NJ 07728  
TEL. 732-780-3779  
FAX. 732-780-6671

CUSTOMER:  
Stephanie Cochran  
3 Autumn Lane  
Burlington, NJ 08016

7.755 KW Solar System  
33- 235W Trina modules

Electrical One Line Diagram  
Revision No. AS-BUILT  
Date: 10/24/11  
Drawn By: WSG