


INSTALLATION OF NEW
ROOF MOUNTED PV SOLAR SYSTEM
505 PROVINCE LINE ROAD
ALLENTOWN, NJ 08501

PROVINCE LINE ROAD ●



VICINITY MAP
SCALE: NTS

SITE

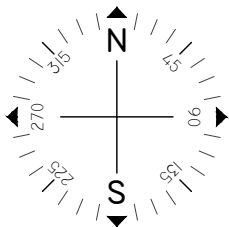

Issued / Revisions

A1	AS BUILT	7/26/2018
P1	ISSUED TO TOWNSHIP FOR PERMIT	6/19/2018
NO.	DESCRIPTION	DATE

Project Title:

HOMMER, NICOLETTE-

TRINITY ACCT #: 2018-04-248184

Project Address:

505 PROVINCE LINE ROAD
ALLENTOWN, NJ 08501
40.102549,-74.567401

Drawing Title:

AS BUILT PV SOLAR SYSTEM

Drawing Information

DRAWING DATE:	6/19/2018
DRAWN BY:	KTD
REVISED BY:	RTC

System Information:

DC SYSTEM SIZE:	12kW
AC SYSTEM SIZE:	10kW
TOTAL MODULE COUNT:	40
MODULES USED:	TRINA 300
MODULE SPEC #:	TSM-300 DD05A.05
UTILITY COMPANY:	JCP&L
UTILITY ACCT #:	100129379069
UTILITY METER #:	S74558958
DEAL TYPE:	DIVIDEND SOLAR

Rev. No.

A1

Sheet

PV - 1



2211 Allenwood Road
Wall, New Jersey 07719

877-786-7283
www.Trinity-Solar.com

GENERAL NOTES

1. THE INSTALLATION CONTRACTOR IS RESPONSIBLE FOR INSTALLING ALL EQUIPMENT AND FOLLOWING ALL DIRECTIONS AND INSTRUCTIONS CONTAINED IN THE DRAWING PACKAGE AND INFORMATION RECEIVED FROM TRINITY.
2. THE INSTALLATION CONTRACTOR IS RESPONSIBLE FOR INSTALLING ALL EQUIPMENT AND FOLLOWING ALL DIRECTIONS AND INSTRUCTION CONTAINED IN THE COMPLETE MANUAL.
3. THE INSTALLATION CONTRACTOR IS RESPONSIBLE FOR READING AND UNDERSTANDING ALL DRAWINGS, COMPONENT AND INVERTER MANUALS PRIOR TO INSTALLATION. THE INSTALLATION CONTRACTOR IS ALSO REQUIRED TO HAVE ALL COMPONENT SWITCHES IN THE OFF POSITION AND FUSES REMOVED PRIOR TO THE INSTALLATION OF ALL FUSE BEARING SYSTEM COMPONENTS.
4. ONCE THE PHOTOVOLTAIC MODULES ARE MOUNTED, THE INSTALLATION CONTRACTOR SHOULD HAVE A MINIMUM OF ONE ELECTRICIAN WHO HAS ATTENDED A SOLAR PHOTOVOLTAIC INSTALLATION COURSE ON SITE.
5. FOR SAFETY, IT IS RECOMMENDED THAT THE INSTALLATION CREW ALWAYS HAVE A MINIMUM OF TWO PERSONS WORKING TOGETHER AND THAT EACH OF THE INSTALLATION CREW MEMBERS BE TRAINED IN FIRST AID AND CPR.
6. THIS SOLAR PHOTOVOLTAIC SYSTEM IS TO BE INSTALLED FOLLOWING THE CONVENTIONS OF THE NATIONAL ELECTRICAL CODE. ANY LOCAL CODE WHICH MAY SUPERSEDE THE NEC SHALL GOVERN.
7. ALL SYSTEM COMPONENTS TO BE INSTALLED WITH THIS SYSTEM ARE TO BE "UL" LISTED. ALL EQUIPMENT WILL BE NEMA 3R OUTDOOR RATED UNLESS INDOORS.

GENERAL NOTES

IF ISSUED DRAWING IS MARKED WITH A REVISION CHARACTER OTHER THAN "A", PLEASE BE ADVISED THAT FINAL EQUIPMENT AND/OR SYSTEM CHARACTERISTICS ARE SUBJECT TO CHANGE DUE TO AVAILABILITY OF EQUIPMENT.

GENERAL NOTES CONTINUED

8. THE DC VOLTAGE FROM THE PANELS IS ALWAYS PRESENT AT THE DC DISCONNECT ENCLOSURE AND THE DC TERMINALS OF THE INVERTER DURING DAYLIGHT HOURS. ALL PERSONS WORKING ON OR INVOLVED WITH THE PHOTOVOLTAIC SYSTEM ARE WARNED THAT THE SOLAR MODULES ARE ENERGIZED WHENEVER THEY ARE EXPOSED TO LIGHT.
9. ALL PORTIONS OF THIS SOLAR PHOTOVOLTAIC SYSTEM SHALL BE MARKED CLEARLY IN ACCORDANCE WITH THE NATIONAL ELECTRICAL CODE ARTICLE 690 & 705.
10. PRIOR TO THE INSTALLATION OF THIS PHOTOVOLTAIC SYSTEM, THE INSTALLATION CONTRACTOR SHALL ATTEND A PRE-INSTALLTION MEETING FOR THE REVIEW OF THE INSTALLATION PROCEDURES, SCHEDULES, SAFETY AND COORDINATION.
11. PRIOR TO THE SYSTEM START UP THE INSTALLATION CONTRACTOR SHALL ASSIST IN PERFORMING ALL INITIAL HARDWARE CHECKS AND DC WIRING CONDUCTIVITY CHECKS.
12. FOR THE PROPER MAINTENANCE AND ISOLATION OF THE INVERTERS REFER TO THE ISOLATION PROCEDURES IN THE OPERATION MANUAL.
13. THE LOCATION OF PROPOSED ELECTRIC AND TELEPHONE UTILITIES ARE SUBJECT TO FINAL APPROVAL OF THE APPROPRIATE UTILITY COMPANIES AND OWNERS.
14. ALL MATERIALS, WORKMANSHIP AND CONSTRUCTION FOR THE SITE IMPROVEMENTS SHOWN HEREIN SHALL BE IN ACCORDANCE WITH:
 - A) CURRENT PREVAILING MUNICIPAL AND/OR COUNTY SPECIFICATIONS, STANDARDS AND REQUIREMENTS

GENERAL NOTES CONTINUED

14. B) CURRENT PREVAILING UTILITY COMPANY SPECIFICATIONS, STANDARDS, AND REQUIREMENTS
15. THIS SET OF PLANS HAVE BEEN PREPARED FOR THE PURPOSE OF MUNICIPAL AND AGENCY REVIEW AND APPROVAL. THIS SET OF PLANS SHALL NOT BE UTILIZED AS CONSTRUCTION DRAWINGS UNTIL REVISED TO INDICATE "ISSUED FOR CONSTRUCTION".
16. ALL INFORMATION SHOWN MUST BE CERTIFIED PRIOR TO USE FOR CONSTRUCTION ACTIVITIES.

ABBREVIATIONS

AMP	AMPERE
AC	ALTERNATING CURRENT
AL	ALUMINUM
AF	AMP. FRAME
AFF	ABOVE FINISHED FLOOR
AFG	ABOVE FINISHED GRADE
AWG	AMERICAN WIRE GAUGE
C	CONDUIT (GENERIC TERM OF SPECIFIED)
CB	COMBINER BOX
CKT	CIRCUIT
CT	CURRENT TRANSFORMER
CU	COPPER
DC	DIRECT CURRENT
DISC	DISCONNECT SWITCH
DWG	DRAWING
EC	ELECTRICAL SYSTEM INSTALLER
EMT	ELECTRICAL METALLIC TUBING
FS	FUSIBLE SWITCH
FU	FUSE
GND	GROUND
GFI	GROUND FAULT INTERRUPTER
HZ	FREQUENCY (CYCLES PER SECOND)


ABBREVIATIONS CONTINUED

JB	JUNCTION BOX
KCMIL	THOUSAND CIRCULAR MILS
KVA	KILO-VOLT AMPERE
KW	KILO-WATT
KWH	KILO-WATT HOUR
L	LINE
MCB	MAIN CIRCUIT BREAKER
MDP	MAIN DISTRIBUTION PANEL
MLO	MAIN LUG ONLY
MTD	MOUNTED
MTG	MOUNTING
N	NEUTRAL
NEC	NATIONAL ELECTRICAL CODE
NIC	NOT IN CONTRACT
NO #	NUMBER
NTS	NOT TO SCALE
OCPP	OVER CURRENT PROTECTION
P	POLE
PB	PULL BOX
PH Ø	PHASE
PVC	POLY-VINYL CHLORIDE CONDUIT
PWR	POWER
QTY	QUANTITY
RGS	RIGID GALVANIZED STEEL
SN	SOLID NEUTRAL
JSWBD	SWITCHBOARD
TYP	TYPICAL
U.O.I.	UNLESS OTHERWISE INDICATED
WP	WEATHERPROOF
XFMR	TRANSFORMER
+72	MOUNT 72 INCHES TO BOTTOM OF ABOVE FINISHED FLOOR OR GRADE


SHEET INDEX

- PV-1 COVER SHEET W/ SITE INFO & NOTES
PV-2 ROOF PLAN W/ MODULE LOCATIONS
PV-3 ELECTRICAL 3 LINE DIAGRAM
AP APPENDIX


NOTES : *REFER TO MODULE SPECS FOR MODULE DIMENSIONS
*DEPICTED MODULES MAY BE PORTRAIT OR LANDSCAPE

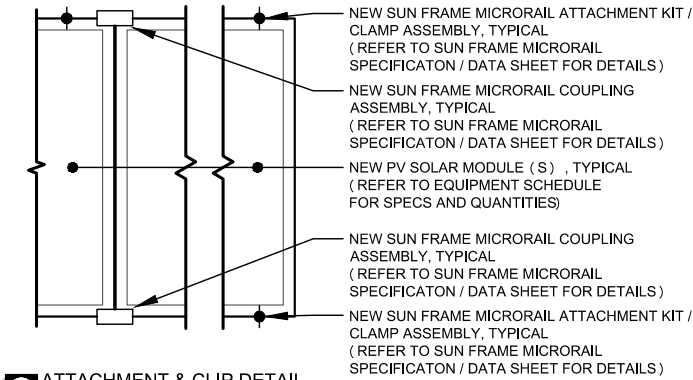

ATTACHMENT & CLIP DETAIL
SCALE: NOT TO SCALE

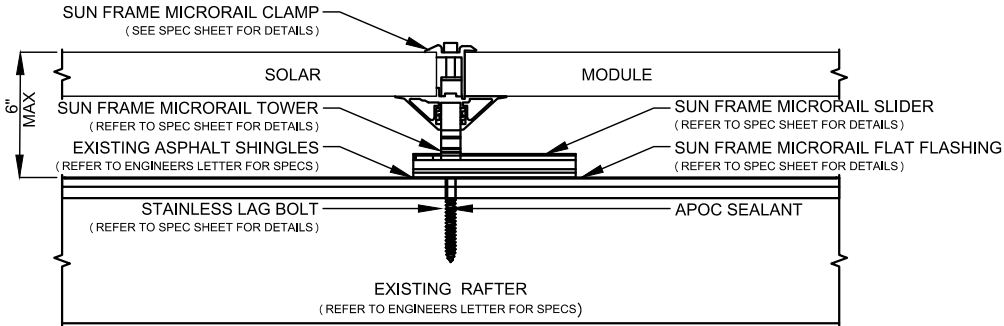

PV MODULE ATTACHMENT ON ASPHALT SHINGLE ROOF
SCALE: NOT TO SCALE

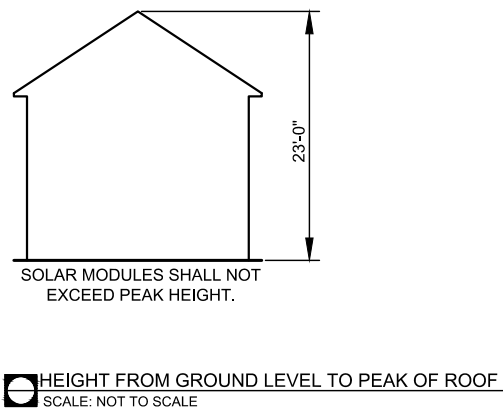

ARRAY SCHEDULE

ROOF 1
MODULES: 0
PITCH: 34°
ORIENTATION: 284°

ROOF 2
MODULES: 0
PITCH: 34°
ORIENTATION: 104°

ROOF 3
MODULES: 24
PITCH: 43°
ORIENTATION: 194°

ROOF 4
MODULES: 0
PITCH: 40°
ORIENTATION: 14°

ROOF 5
MODULES: 16
PITCH: 35°
ORIENTATION: 194°

ROOF 6
MODULES: 0
PITCH: 45°
ORIENTATION: 14°

ROOF 7
MODULES: 0
PITCH: 40°
ORIENTATION: 14°

ROOF 8
MODULES: 0
PITCH: 40°
ORIENTATION: 14°

ROOF 9
MODULES: 0
PITCH: 40°
ORIENTATION: 194°

ROOF 10
MODULES: 0
PITCH: 40°
ORIENTATION: 14°

ROOF 11
MODULES: 0
PITCH: 40°
ORIENTATION: 194°

ROOF 12
MODULES: 0
PITCH: 40°
ORIENTATION: 194°


ROOF 13
MODULES: 0
PITCH: 18°
ORIENTATION: 194°

ROOF 14
MODULES: 0
PITCH: 18°
ORIENTATION: 14°

ROOF 15
MODULES: 0
PITCH: 8°
ORIENTATION: 104°

ROOF 16
MODULES: 0
PITCH: 34°
ORIENTATION: 194°

ROOF 17
MODULES: 0
PITCH: 34°
ORIENTATION: 14°

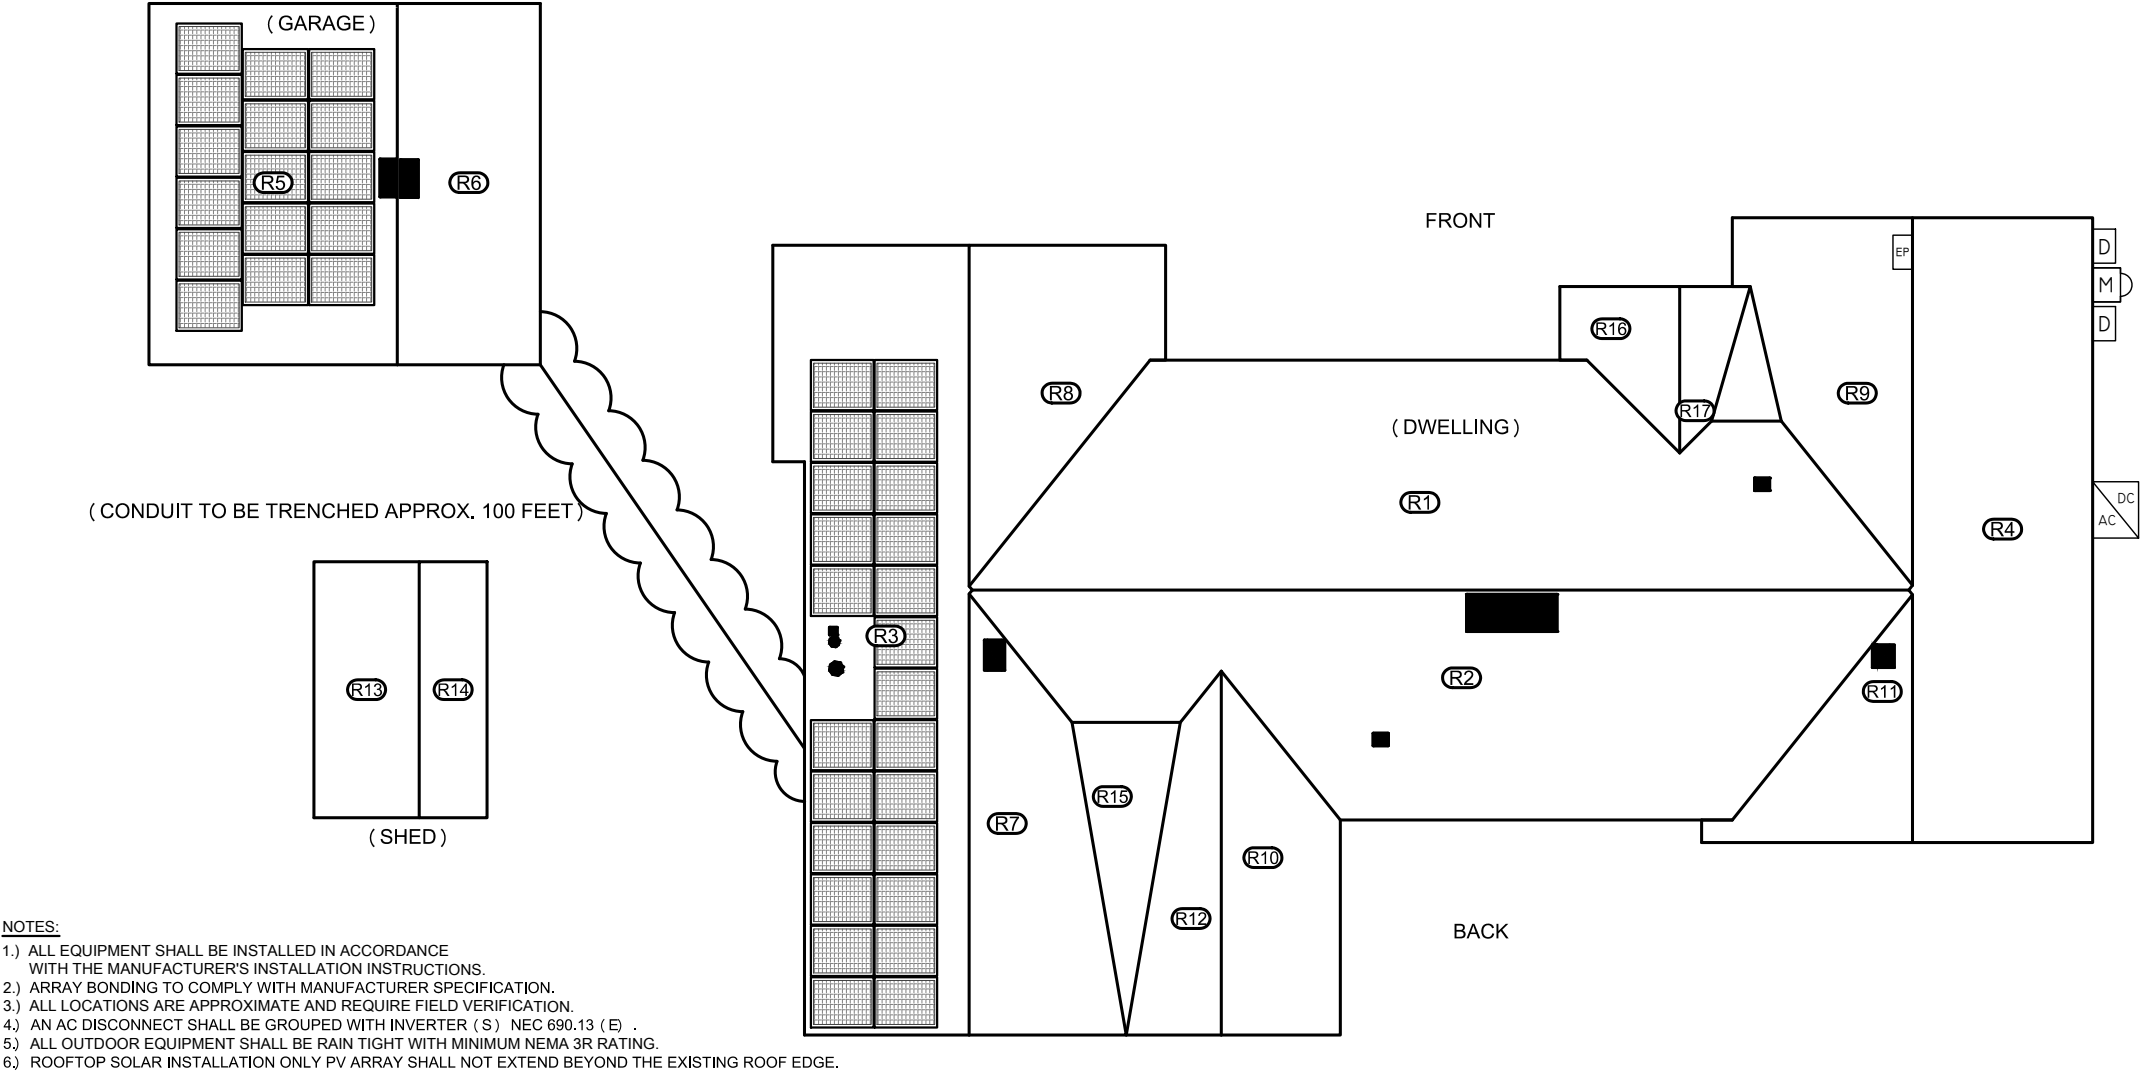

NOTES:

- 1.) ALL EQUIPMENT SHALL BE INSTALLED IN ACCORDANCE WITH THE MANUFACTURER'S INSTALLATION INSTRUCTIONS.
- 2.) ARRAY BONDING TO COMPLY WITH MANUFACTURER SPECIFICATION.
- 3.) ALL LOCATIONS ARE APPROXIMATE AND REQUIRE FIELD VERIFICATION.
- 4.) AN AC DISCONNECT SHALL BE GROUPED WITH INVERTER (S) NEC 690.13 (E) .
- 5.) ALL OUTDOOR EQUIPMENT SHALL BE RAIN TIGHT WITH MINIMUM NEMA 3R RATING.
- 6.) ROOFTOP SOLAR INSTALLATION ONLY PV ARRAY SHALL NOT EXTEND BEYOND THE EXISTING ROOF EDGE.

SYMBOL LEGEND


	INDICATES ROOF DESIGNATION . REFER TO ARRAY SCHEDULE FOR MORE INFORMATION		INDICATES NEW UTILITY DISCONNECT TO BE INSTALLED OUTSIDE		INDICATES NEW PV ONLY SUBPANEL TO BE INSTALLED
	INDICATES EXISTING METER LOCATION		INDICATES NEW PV SOLAR MODULE. RED MODULES INDICATE PANELS THAT USE MICRO INVERTERS. REFER TO EQUIPMENT SCHEDULE FOR SPECS.		
	INDICATES EXISTING ELECTRICAL PANEL LOCATION: OUTSIDE		INDICATES NEW PRODUCTION METER TO BE INSTALLED OUTSIDE.		
	INDICATES NEW FUSED PV DISCONNECT TO BE INSTALLED OUTSIDE		INDICATES NEW INVERTER TO BE INSTALLED OUTSIDE. REFER TO EQUIPMENT SCHEDULE FOR SPECS.		

PLUMBING SCHEDULE

OTHER OBSTRUCTIONS	

EQUIPMENT SCHEDULE

QTY	SPEC #
40	TRINA 300 (TSM-300 DD05A.05)
1	SE10000A-US000NNR2

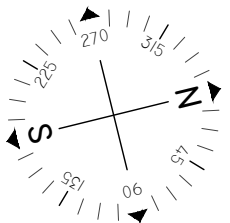

Issued / Revisions

A1	AS BUILT	7/26/2018
P1	ISSUED TO TOWNSHIP FOR PERMIT	6/19/2018
NO.	DESCRIPTION	DATE

Project Title:

HOMMER, NICOLETTE-

TRINITY ACCT #: 2018-04-248184

Project Address:

505 PROVINCE LINE ROAD
ALLENTOWN, NJ 08501
40.102549,-74.567401

Drawing Title:

AS BUILT PV SOLAR SYSTEM

Drawing Information

DRAWING DATE:	6/19/2018
DRAWN BY:	KTD
REVISED BY:	RTC

System Information:

DC SYSTEM SIZE:	12kW
AC SYSTEM SIZE:	10kW
TOTAL MODULE COUNT:	40
MODULES USED:	TRINA 300
MODULE SPEC #:	TSM-300 DD05A.05
UTILITY COMPANY:	JCP&L
UTILITY ACCT #:	100129379069
UTILITY METER #:	S74558958
DEAL TYPE:	DIVIDEND SOLAR

Rev. No.

A1

Sheet

PV - 2



2211 Allenwood Road
Wall, New Jersey 07719

877-786-7283
www.Trinity-Solar.com

1.) LICENSED ELECTRICIAN ASSUMES ALL RESPONSIBILITY FOR DETERMINING ONSITE CONDITIONS AND EXECUTING INSTALLATION IN ACCORDANCE WITH NEC 2014

3.) HIGHEST CONTINUOUS AMBIENT TEMPERATURE BASED ON ASHRAE HIGHEST MONTH 2% DRY BULB TEMPERATURE FOR ASHRAE LOCATION MOST SIMILAR TO INSTALLATION LOCATION. HIGHEST CONTINUOUS TEMP = **33°C**

5.) PV SYSTEM CIRCUITS INSTALLED ON OR IN BUILDINGS SHALL INCLUDE A RAPID SHUTDOWN FUNCTION THAT CONTROLS SPECIFIC CONDUCTORS IN ACCORDANCE WITH NEC 690.12(1) THROUGH (5)

7.) UNGROUNDED DC CIRCUIT CONDUCTORS SHALL BE IDENTIFIED WITH THE FOLLOWING OUTER FINISH:
POSITIVE CONDUCTORS = RED
NEGATIVE CONDUCTORS = BLACK
NEC 210.5(C)(2)

9.) ALL WIRE LENGTHS SHALL BE LESS THAN 100' UNLESS OTHERWISE NOTED

11.) OVERCURRENT PROTECTION FOR CONDUCTORS
CONNECTED TO THE SUPPLY SIDE OF A SERVICE SHALL BE
LOCATED WITHIN 10' OF THE POINT OF CONNECTION NEC
705.31


13.) ALL SOLAR SYSTEM LOAD CENTERS TO CONTAIN ONLY GENERATION CIRCUITS AND NO UNUSED POSITIONS OR LOADS

CALCULATIONS FOR CURRENT CARRYING CONDUCTORS
REQUIRED CONDUCTOR AMPACITY PER STRING
[NEC 690.8(B)(1)]: $(15.00 \times 1.25)1 = 18.75A$

30.72A \geq 18.75A, THEREFORE WIRE SIZE IS VALID

AWG #6, DERATED AMPACITY
 AMBIENT TEMP: 30°C, TEMP DERATING: 1.0
 RACEWAY DERATING ≤ 3 CCC: N/A
 75A*1.0 = 75A

CALCULATION FOR PV OVERCURRENT PROTECTION
TOTAL INVERTER CURRENT: 42.00A
 $42.00A \times 1.25 = 52.50A$
--> 60A OVERCURRENT PROTECTION IS VALID

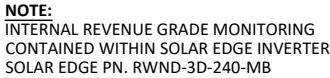

INVERTER #1 - SE10000A-US000NNR2			
DC		AC	
Imp	30.5	Pout	10000
Vmp	350	Imax	42
Voc	500	OCPDmin	52.5
Isc	45	Vnom	240

A	#6 THWN-2 GEC TO EXISTING GROUND ROD	G	3/4" CONDUIT W/ 2-#6 THWN-2, 1-#6 THWN-2, 1-#8 THWN-2 GROUND
B	3/4" CONDUIT W/ 2-#6 THWN-2, 1-#10 THWN-2, 1-#10 THWN-2 GROUND	H	1" PVC W/ 6-#10 THWN-2, 1-#8 THWN-2 GROUND (TRENCHED APPROX. 100')
C	3/4" CONDUIT W/ 6-#10 THWN-2, 1-#10 THWN-2 GROUND	I	3/4 " CONDUIT W/ 2-#10 THWN, 1-#10 THWN -2 GROUND
D	3/4" CONDUIT W/ 4-#10 THWN-2, 1-#10 THWN-2 GROUND		
E	3/4" CONDUIT W/ 2-#6 THWN-2, 1-#10 THWN-2, 1-#10 THWN-2 GROUND		
F	#10 PV WIRE (FREE AIR) W/ #6 BARE COPPER BOND TO ARRAY		



Trinity[®]
SOLAR

2211 Allenwood Road
Wall, New Jersey 07719

877-786-7283
www.Trinity-Solar.com